


Section 6 Township 25 Range 13W
 Well No. #1 Seevers
 Company Natural Gas & Oil

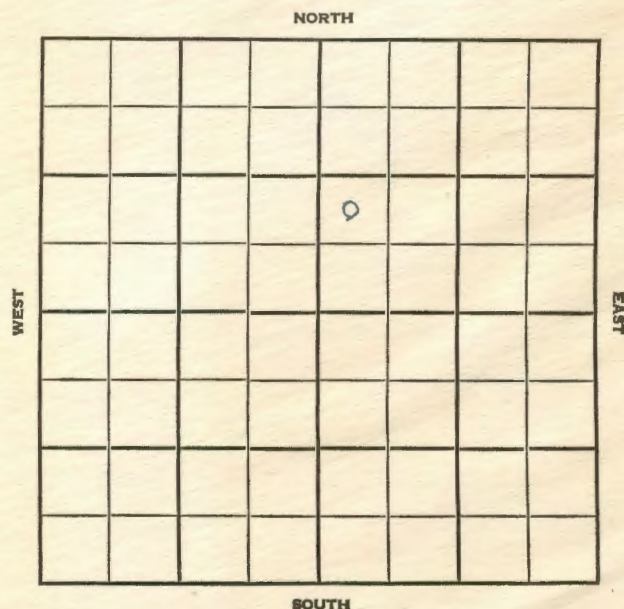

SEC.

6

TWP.

25

R.

13W

WELL NO.

#1 Seevers

FARM

COMPANY

Natural Gas & Oil

CONTRACTOR

M & R


NW Seevers

_____ FT. FROM N. LINE

_____ FT. FROM S. LINE

_____ FT. FROM E. LINE

_____ FT. FROM W. LINE

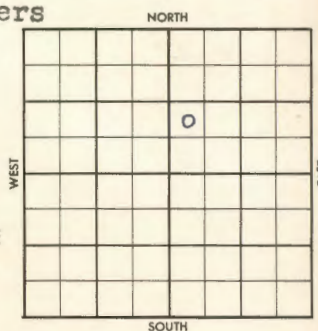

NW SW NE

	ELEVATION	REPORT
1956	1954'	
6-27	Comm. 6-25-56	
	8" @ 185/225 WOC	
8-1	DST 3689-3724 op 1 hr. rec. 150' Sli Gssy WM, BHP 100/15"	
	DST 3788-3824 op 1 hr, gas in 23 min. rec. 60' VHOCM / 125' mdy oil / 120' clean oil, BHP 1290/15"	
	DST 3829-70 op 1 hr. rec. 30' mud, BHP 610/15" H. 3486'; BL. 3626';	
	DST 3876-3902 op 1 hr. gas in 50 min, rec. 160' SO&GCM / 50' SW, 620/15"	
	DST 3986-4020 op 1 hr. gas in 17 min, #### rec. 55' GCM, 1150/15".	
	DST 4122-56 op 1 hr., rec. 30' mud, BHP 0/15" L. 3649'; BKC 3890';	
	DST 4231-35 op 1 hr., rec. 12' mud, BHP 0/15". M. 4005'; K. 4032';	
	DST 4235-40 op 1 hr., rec. 25' mud, BHP 190/15". V. 4094'; S. 4184';	
	5 1/2" @ 3926 A. 4230';	
	CO 3911, 16/3890-94	
	B/ 2 bwph,	
	PB 3850 24/3816-22, 18/3826-29	
	B/ 15 gw in 3 hrs.,	
	S/ 43 BO, 1 hr., no/wtr.,	
	S/ 35 BO, no/wtr., 1 hr., Grav. 32.	
	Ph. P/125 BOPD, / 2% wtr., Grav. 30.	
	TD 4240'	

FORM 504-5 SUNRAY

COMPLETED

County <u>Stafford</u>		Elev. _____		Co.
Sec. <u>6</u>	Twp. <u>25</u>	Rgs. <u>13W</u>		
Company <u>Natural Gas & Oil</u>				
Farm Name <u>Seevers</u>		No. <u>1</u>		

TOPS	DEPTH	LOG	DATUM	Loc. in Sec.
Anh.				NW SW NE
Tr.				
H.				
Tr.				
Dg.				
Bl.				
L.				Geol. _____
K.C.				Contr. _____
B.K.C.				
Ce.				M & R
C.				
M.				Pool
K.				NW Seevers
Mz.				
Me.				
V.				
S.				
S.				
A.				
R.				
Pe.				
G.				
TD.				

Date Comm. 6-25-56

8" @ 185/225 WOC

22K

22

22K

County Stafford Elev. 1954
 Sec. 6 Twp. 25 Rge. 13W
 Company Natural Gas & Oil
 Farm Name Seevers No. 1

TOPS	DEPTH	LOG	DATUM	Loc. in Sec.
Ank.				NW 1/4 NE
TP	3486			
H.				
Tr.				
Dg.				
Bl.	3626			
L.	3649			
K.C.				Geol.
B.K.C.	3890			Contr.
Ce.				11 & B
C.	4005			
M.				Pool
K.	4032			NW Seevers
Me.				
Ma.				
V.	4094			
S.	4184			
S.				
A.	4230			
R.				
Pe.				
G.				
TO	4240			

COMPLETE

Date Comm. 6-25-56 AUG 1 1956

8" @ 185/225 100 JUL 3 '56 @ 3418

JUL 11 '56 DST 3689-3724 1hr. res
 150' S.G. ss y WM BHP 100/15"
 DST 3788-3824 1hr. g in 23"
 60' V.H. OCM + 125' Mdy oil + 120'
 clean oil BHP 1290/15" DST
 3829-70 1hr. 30' Md BAP 610/15"
 DST 3876-3902 1hr. g in 50"
 res 160' 50' 46CM + 50' SW 620/15"

DST 3986-4020 1hr. g in 17"
 TSTM res 55' 6CM 1150/15"
 DST 4122-56 1hr. res 30' Md
 BHP 0/15 DST 4231-35 0/15
 1hr. 12' Md BHP 0/15" DST
 4235-40 1hr. res 25' Md
 BHP 190/15" 5 1/2 @ 3926
 JUL 18 '56 Co 3911 16/3890-94
 @ 2 BW ph PB 3850 24/
 3816-22 18/3826-29 @
 15 GW in 3 hrs 11/10 \$
 43 BO 1hr. nolw \$
 35 BO nolw 1hr. gran 32°
 JUL 18 '56 AUG 1 '56 Ph P. 125 Bopd
 + 2% wts gran 30°