



Section 8 Township 25 Range 13W  
 Well No. 1 W. H. Shank  
 Company Magnolia Petr.

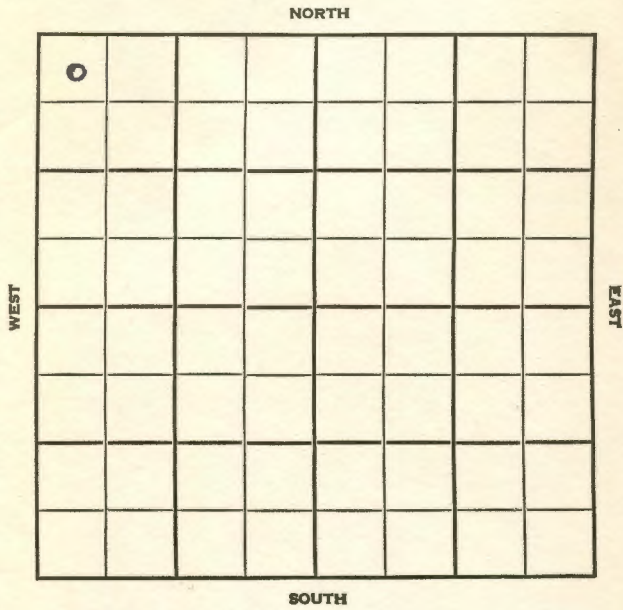

SEC. 8 TWP. 25 R. 13 W  
 WELL NO. # 1 W. H. Shank FARM  
 COMPANY Magnolia et.  
 CONTRACTOR Prime Drlg.

Seevers Pool  
330 Ft. from N. Line  
 Ft. from S. Line  
 Ft. from E. Line  
330 Ft. from W. Line

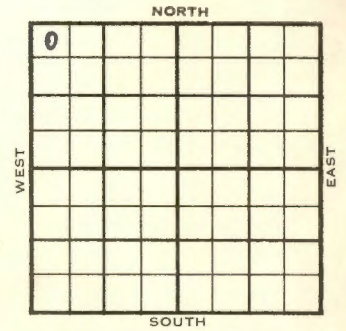

NW NW NW

	ELEVATION	REPORT
1955		
4/20		Spud 4-18-55

