


KANSAS

Section 9 Township 25 Range 13WWell No. 1 CornwellCompany Lawson Petr.

NORTH

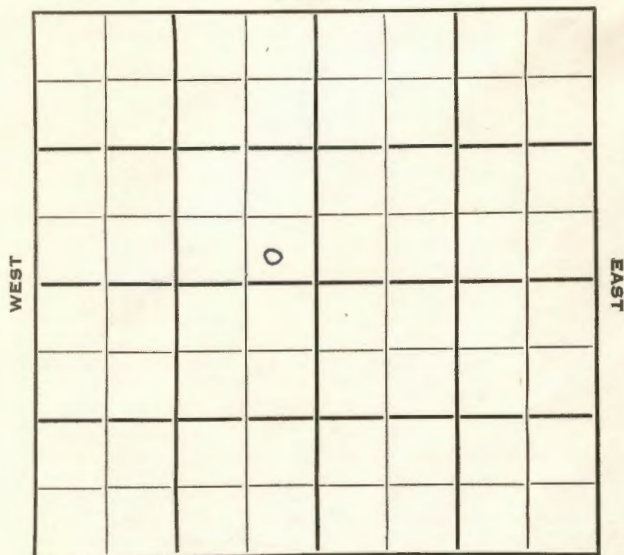

SOUTH


Stafford

KANSAS ✓

Sec. 9 Twp. 25 R. 13WWell No. #1 Cornwell FarmLawson Petr. CompanyB & B Drlg. ContractorWildcat Ft. from N. Line330 Ft. from S. Line330 Ft. from E. Line Ft. from W. Line

SE SE NW

NORTH

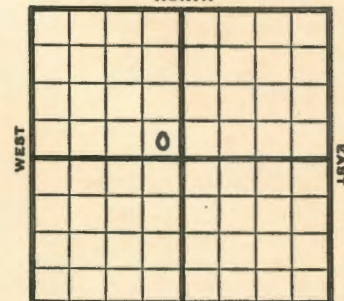

SOUTH

1953

Elev. 1948' REPORT

4/8
4/16MIR
8" @ 345'
Drlg 3200'

4/23

Drlg 4173'

4/29

Spud 4-8-53 D & A TD 4320
 8" @ 345' Heeb 3514 Br lime 3561
 Lans 3685 Cong 4041
 DST 4066-4101 open 1 hr, rec 30'
 mud. 50#
 Viola 4142 Simp 4244
 DST 4233-66 open 1 hr. rec 30' mud
 O# Arb. 4293 TD 4320
 D & A

ABANDONED

J. G. McGEHEE

J. G. McGEHEE