

STATE CORPORATION COMMISSION OF KANSAS
OIL & GAS CONSERVATION DIVISION

WELL COMPLETION OR RECOMPLETION FORM
ACO-1 WELL HISTORY

DESCRIPTION OF WELL AND LEASE

Operator: license # 5316
name Falcon Exploration Inc.
address 1531 Kansas State Bank Bldg.
Wichita, Kansas 67202
City/State/Zip

Operator Contact Person Micheal S. Mitchell
Phone (316) 262-1378

Contractor: license # 5138
name Cougar Drilling Co., Inc.

Well-site Geologist Craig Snider
Phone (316) 262-1378

PURCHASER Clear Creek, Inc.

Designate Type of Completion
 New Well Re-Entry Workover

Gas SWD Temp Abd
 Dry Inj Delayed Comp.
 Other (Core, Water Supply etc.)

If OWWO: old well info as follows:
Operator
Well Name
Comp. Date Old Total Depth

WELL HISTORY

Drilling Method: Mud Rotary Air Rotary Cable
2-28-84 3-11-84 4-19-84
Spud Date Date Reached TD Completion Date

4376 4324
Total Depth PBD

Amount of Surface Pipe Set and Cemented at 349 feet

Multiple Stage Cementing Collar Used? Yes No

If Yes, Show Depth Set feet

If alternate 2 completion, cement circulated NA
from feet depth to w/ SX cmt

Wireline Log Rec'd

API NO. 15 - 185-21,958

County Stafford

50'W SE NE SW Sec 5 Twp 25S Rge 14
(location)

1650 Ft North from Southeast Corner of Section
3020 Ft West from Southeast Corner of Section
(Note: locate well in section plat below)


Lease Name Wilson Well# 2

Field Name Moody NE

Producing Formation KC and Miss.

Elevation: Ground 2008 KB 2018

Section Plat

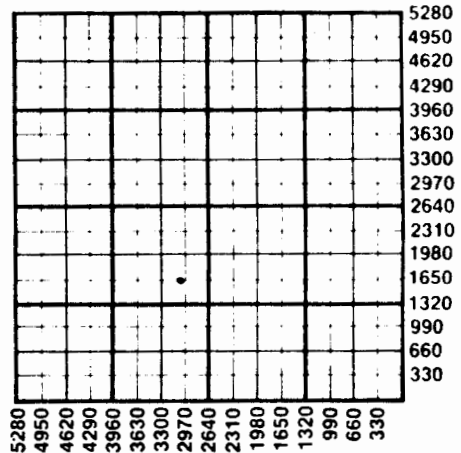

WATER SUPPLY INFORMATION

Source of Water:

Division of Water Resources Permit # T84-128

Groundwater 1650 Ft North From Southeast Corner and
2970 Ft West From Southeast Corner of
Sec 5 Twp 25 Rge 14 East West

Surface Water Ft North From Southeast Corner and
(Stream, Pond etc.) Ft West From Southeast Corner
Sec Twp Rge East West

Other (explain)
(purchased from city, R.W.D.#)

Disposition of Produced Water: Disposal Repressuring

Docket #

INSTRUCTIONS: This form shall be completed in duplicate and filed with the Kansas Corporation Commission, 200 Colorado Derby Building, Wichita, Kansas 67202, within 90 days after completion or recompletion of any well. Rules 82-3-130 and 82-3-107 apply.

Information on side two of this form will be held confidential for a period of 12 months if requested in writing and submitted with the form. See rule 82-3-107 for confidentiality in excess of 12 months.

One copy of all wireline logs and drillers time log shall be attached with this form. Submit CP-4 form with all plugged wells. Submit CP-111 form with all temporarily abandoned wells.

All requirements of the statutes, rules, and regulations promulgated to regulate the oil and gas industry have been fully complied with and the statements herein are complete and correct to the best of my knowledge.

5-25-14W¹

ALCON EXPLORATION INC.

OIL & GAS EXPLORATION

KSB Bldg.-Suite 1531
125 N. Market
Wichita, Kansas 67202
(316) 262-1378

Continuation of Side Two - ACO-1 Well History Form:

Wilson #2 Sec. 5-25S-14W, Stafford County, Kansas

DST #7 4266-4308 30-45-30-45
IHP 2289, IFP 78-78, ISIP 157, FFP 88-88, FSIP 157, FHP 2289

Tubing Record:

Size: 2 1/16". Dually completed gas string, 2 1/16" tbg., set @ 4060'. Baker
Retrievable Model "D" prod. packer, set @ 4060'. Oil string 2 1/16" tbg. set @ 3994'.

TUBING RECORD size 2 1/16" set at		See additional page -- packer at		Liner Run <input type="checkbox"/> Yes <input checked="" type="checkbox"/> No	
Date of First Production 4-19-84	Producing method <input type="checkbox"/> flowing <input checked="" type="checkbox"/> pumping <input type="checkbox"/> gas lift <input type="checkbox"/> Other (explain)				
Estimated Production Per 24 Hours ➔	Oil	Gas	Water	Gas-Oil Ratio	Gravity
	20 Bbls	Shut-in MCF	1 Bbls	NA CFPB	39°

Disposition of gas: vented open hole perforation
 sold -not sold at present other (specify)

used on lease Dually Completed.
 Commingled

PRODUCTION INTERVAL
3990-3993'
KC - 3885-3888'
Miss. 4138-54 (SI)