


Section 2 Township 25 Range 14 W

Well No. # 1 Bowker

Company W. L. Hartman

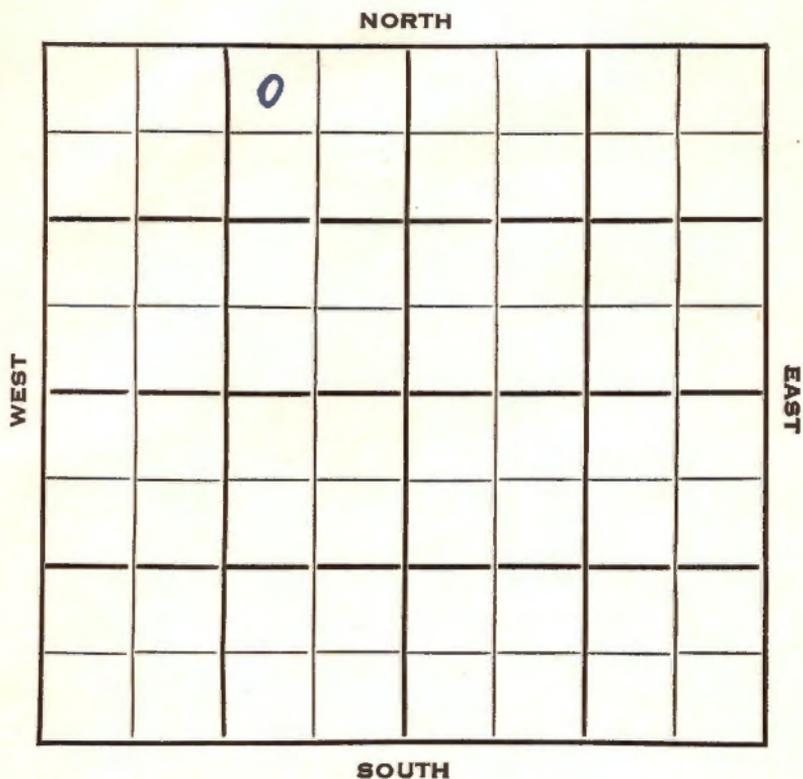

Stafford

KANSAS


SEC.	TWP.	R.
2	25	14W ✓

WELL NO. **1 Bowker** FARM

COMPANY **W. L. Hartman**

CONTRACTOR **Hartman Wildcat**

330 Ft. from N. Line
 Ft. from S. Line
990 Ft. from E. Line
 Ft. from W. Line

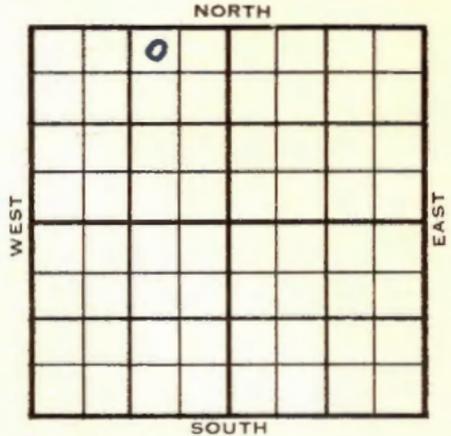

NW NE NW
Phillips-DHM

	ELEVATION	REPORT
1953	1951'	
10/28	Spud 10-26-53 8" @ 225, WOC	
11/4	Heeb 3473' Drlg 3550'	
11/11	Br. L. 3608', Lans 3639' DST 3692'-3716' 1 hr, 195' gas, 35' SO&GCM, 100# DST 3720'-36' 40 mins, 965' SW 1380# DST 3766'-80' 1 hr, 2400' gas, 32' OCM 300#. DST 3800'-22' 1 hr, 20' VSO&GCM, 70# B KC 3924', Miss 3991', KH 4016' Drlg.	
11/18	V 4054', Simp 4187', Arb 4224' DST 4225'-32'	

OVER

1953
11/24

Spud 10-26-53

D&A

TD 4232'

8" @ 225'

Heeb 3473', Top 3063', Br lime 3608'

Lans 3639'

DST 3692-3716', opn 1 hr., rec. 175'
gas, 35' so & gcm, 100#

DST 3720-36, opn 40 mins., rec. 965'
sw, 1380#

DST 3766-80, opn 1 hr., rec. 2400'
gas, 32' ocm, 300#

DST 3800-22, opn 1 hr., rec. 20'
vso & gcm, 70#

B KC 3924', Miss 3991', Kh. 4016',

Viola 4054', Simp. 4187', Arb. 4224'

DST 4225-32', opn $\frac{1}{2}$ hrs., failed

TD 4232'

D&A

ABANDONED

