
Stafford

KANSAS

SECTION 2 TOWNSHIP 25S RANGE 14W

WELL NO. #2 Bowker

COMPANY Sterling Drlg.

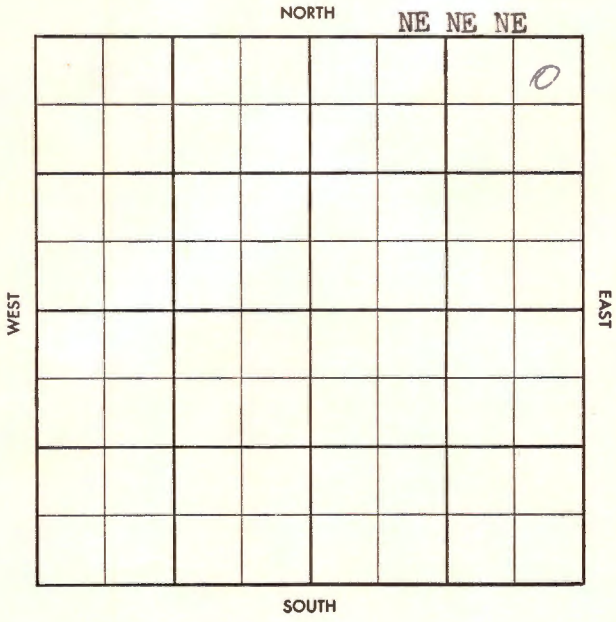

FORM 504-S SUNRAY

S-513-B

County Stafford Elev. 1953

Sec. 2 Twp. 25 Rge. 14W

Company Sterling Drlg.

Farm Name Bowker No. 2

TOPS	DEPTH	LOG	DATUM
Anh.			
Tp.			
H.			
Tr.			
Dg.			
B. L.			
L.			
K.C.			
B.K.C.			
Ce.			
C.			
M.			
M.			
K.			
Mz.			
Mq.			
V.			
S.			
S.			
A.			
R.			
Pf.			
G.			
T.D.			

Loc. in Sec. NE NE NE

Geol.

Contr. Group Exp.

Pool Morning Star



Date Comm. 6-30-58


8" @ 320/225 drlg. 3562

Co.

Sec.

T.

R.

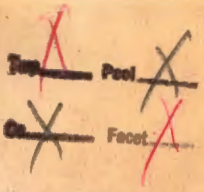

S-B13-B

County Stafford Elev. 1953

Sec. 2 Twp. 25 Rge. 14W

Company Sterling Drlg.

Farm Name Bowker No. 2

TOPS	DEPTH	LOG	DATUM
Anh.			
Tp.			
H.	3501		
Tr.	3520		
Dg.	3540		
B.L.	3639		
L.	3668		
K.C.			
B.K.C.			
Ce.			
C.			
M.	4003		
M. Chert	4026		
K.			
Mz.			
Mq.			
V.	4107		
S.			
S.			
A.			
R.			
Pf.			
G.			
T.D.	4248		

Loc. in Sec. NE NE NE

Geol.

Contr. Group Exp.

Pool Morning Sta

ABANDONED

JUL 16 '58

Date Comm. 6-30-58

8" @ 320/225 drlg. 3562 JUL 16 '58 DST 3695-3700 1hr 50'M BHP 100/2 DST 4003-55 1hr 120'Hgcm SSO BHP 388/20" DST 4003-55 1hr 2250' gip 120 Hgcm VSSO BHP 275 mw/og

D&A