

Sec. 2 Twp. 25 R. 14W

Well No. #3 Bowker Farm _____

Texas Company Company

Noble Drlg. Contractor

Cephas Pool


_____ Ft. from N. Line

330 Ft. from S. Line

990 Ft. from E. Line

_____ Ft. from W. Line

SW SE SE

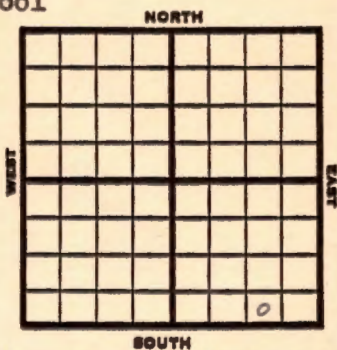

1953

Elev. 1959'

REPORT

8/5

Spud 7-29-53
10-3/4" @ 883'
Drlg 3120'

8/12

**Heeb 3505, Br. L. 3644, Lans 3676,
B KC 3960, V. 4120**
TD 4185'
7" @ 4184'

8/19

C.O.

9/2

Spud 7-29-53
Oil Well
TD 4185'
10-3/4" @ 883'
**Heeb 3505, Br. Lime 3644, Lans 3676,
B KC 3960, Cong 4026, Kh 4031, Viola
4120**
TD 4185'
7" @ 4184'
CO to 4177 76/ 4148-66 1 gwph 500 A
6 go 7 gwph 2000 A S/ 1 1/2 boph
sd-frac S/ 1 1/2 bo 7 bwph PB 4144
16/ 4139-41 1 bo 1/2 bwph 500 A S/ 3/4
bf 15 hr. 20% wtr.
2000 A S/ 4 boph 6 % wtr. CO to 4176
7 boph 3% wtr. 5 hr.
Comp. 210 bopd.

COMPLETED

