

Stafford

FORM 51

KANSAS

Section 2 Township 25 Range 11W

Well No. #3 Hattie "B"

Company Phillips ¹ et.

NORTH

SOUTH

WEST

EAST

Stafford

KANSAS

SEC.	TWP.	R.
2	25	14W ✓

WELL NO.

#3 Hattie "B"

FARM

COMPANY

Phillips Pet.

CONTRACTOR

Phillips

Cephas Pool

990


Ft. from N. Line

Ft. from S. Line

330

Ft. from E. Line

Ft. from W. Line

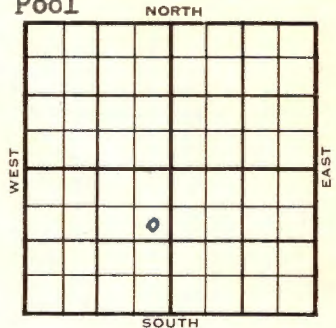

SE NE SW

	ELEVATION	REPORT
1954	1961'	
2/3	Spud 1-30-54 8" @ 868' WOC.	
2/10	Heeb 3504', Tor 3523', Br. L. 3641' Lans 3672'	
2/17	Drlg 3890' B KC 3953' Marm 3964' Miss 4018', Kh 4051' V 4114, Simp 4275' TD 4280' Schl 5" @ 4275'	
2/24	CO 4242 48/ 4155-67 S/ 4½ gw 2 hrs. 500 A S/ 2½ bo / 5 bw 7½ hrs PB 4148' 56/ 4131-45 B/ 29½ go & 2 bw 3 hrs 500 A S/ 16 BO / 12 BW 8 hrs S/ 36½ bo / 4½ BW 15 hrs 2500 A S/ down F 259 BO / 2½ BW 8½ hrs.	
OVER		

1954
3/17

Spud 1-30-54 Oil well TD 4280
8" @ 868 Heeb 3504 Tor. 3523
Br. lime 3641 Lans 3672
B KC 3953 Marm 3964 Miss 4018
Kh. 4051 Viola 4114 Simp 4275
TD 4280 5" @ 4275 CO to 4242
48/4155-67 S/4 $\frac{1}{2}$ GW 2 hr. 500 A
S/2 $\frac{1}{2}$ BO 5 BW 7 $\frac{1}{2}$ hr. PB 4148
56/4131-45 B/29 $\frac{1}{2}$ GO 2 BW 3 hr.
500 A S/16 BO 12 BW 8 hr.
S/36 $\frac{1}{2}$ BO 4 $\frac{1}{2}$ BW 15 hr. 2500 A
S/down F/259 BO 2 $\frac{1}{2}$ BW 8 $\frac{1}{2}$ hr.
Comp. 1793 BOPD

COMPLETED

County Stafford State Kansas

Sec. 2 (Blk.) 25 (Sur.) 14W Map No.

Operator Phillips Pet.

Well No. 3 Farm Hattie "B"

Elev.	Location	SE	NE	SW
100	100	100	100	100

990 Ft. From N Line SW

330 Ft. From Line Quarter

1st. Report FEB 3 1954

Completion

Remarks

Phillips - Contr.

Spudding Date 1-30-54

Drig. Data Cerbas Pool

8" @ 868 WGC

J. G. McGEHEE

