


Section 2 Township 25 Range 14 W

Well No. # 1 Toland "B" - "A"

Company Helmerich & Payne

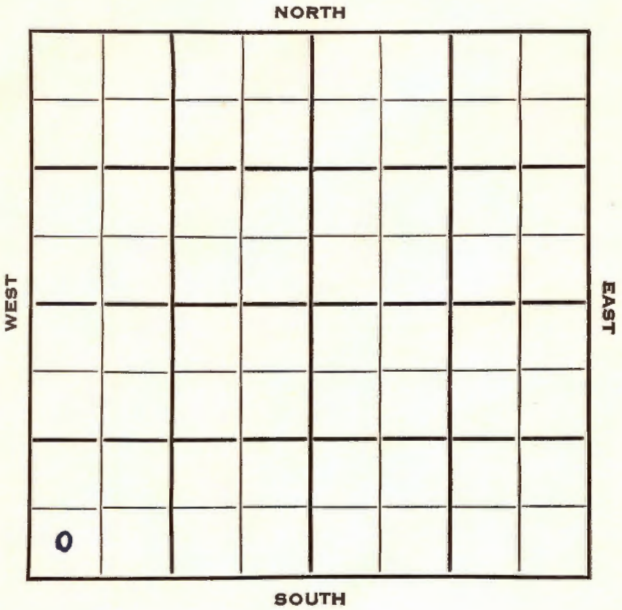

Sec. 2 Twp. 25 R. 14W

Well No. #1 Toland "A" Farm

Helmerich & Payne Company

Lewis Drlg. Contractor
Cephas Pool


 Ft. from N. Line

330 Ft. from S. Line

 Ft. from E. Line

330 Ft. from W. Line

SW SW SW

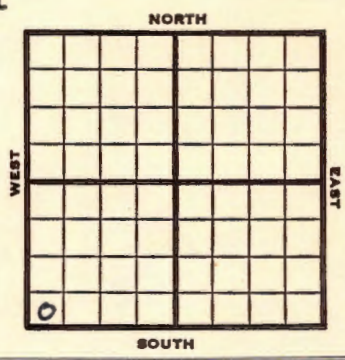

1953 **Elev. 1956'** REPORT

5/27 Location
6/3 C & P
6/10 8" @ 858
Anhy 858'
Drlg. 2634'

6/24 NR
7/1 Spud 6-3-53
Oil Well
TD 4200'
8" @ 858'
Anhy 858, Heeb 3507, Br. Lime 3649,
Lans 3678
DST 3800-19 opn 1½ hr, rec 50' O&GCM
50' SW 475# **Cong 4032, Viola 4118,**
DST 4118-54 opn 1 hr, rec 420' mco
1120#
TD 4200'
5" @ 4199'
CO to 4159' 40/ 4120-28 1½ boph
500 A F/ 6 boph 1000 A
F/ 20 boph Comp/ 243 bopd.

COMPLETED

Map No. _____ Sec. 2 Twp. 25 R. 14WWell No. 1 Toland "A"Helmerich & Payne CompanyCORRECTION Contractor

SW SW SW

SECTION PLAT

_____ Ft. from N. Line

330 Ft. from S. Line

_____ Ft. from E. Line

330 Ft. from W. Line

o			

Stafford County

Location _____

Rig up _____

Drilling and Remarks:

Reported
#1 Toland "B"

RECORD

Cased _____ in., _____ ft.

Sand _____

Gas _____

Oil _____

Total Depth _____

PRODUCTION

1st 24 hrs. Nat. _____

1st 24 hrs. after shot _____

Gas _____ Cu. Ft.

Dry Hole _____

Abandoned _____

Date

MUN 24 1953 19J. G. McGEHEE Scout