


SECTION ~~29~~ 9 TOWNSHIP 25S RANGE 14W

WELL NO #2 Hammond

COMPANY C.S.O.

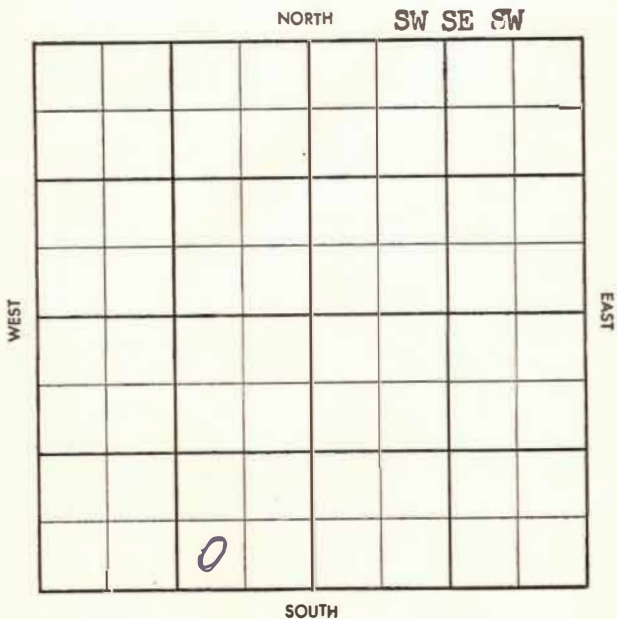



~~26~~  
CORRECTION

8-513.A

CO. Stafford ELEV. 1989  
SEC. 19 TWP. 25 RGE. 14W  
COMPANY C.S.C. NO. 2

ABANDONED	
DEC 11 '57	

FARM Harmond  
LOC. SW SE SW


GEOL. \_\_\_\_\_  
CONTR. Glen Peel tools  
POOL Harmond  
SPUD 11/20/57  
8" @ 409 W/275, Drls.  
2305. DEC 4-57 L 3730  
DST 3772-3813  
60" 240 MGSW  
↓ 50 SW BHP  
1210/30" DST

3861-77 60" 35' 50 CM  
5' 0 CM 790/30" DST  
3879-3908 60" 39' M BHP  
1142/30" DST 3909-27 60"  
90' M. . . . .  
DST 3939-54 60" 5' 0 CM  
30' M + SW 65' SW BHP 1020/30"  
PKC 4019 TD 4035

D6A

CO. \_\_\_\_\_  
LSE. \_\_\_\_\_  
NO. \_\_\_\_\_  
SEC. \_\_\_\_\_  
TWP. \_\_\_\_\_  
RGE. \_\_\_\_\_