Stafford **KANSAS**

9 25S 14W

SECTION TOWNSHIP RANGE


#2 Hammond "A"

WELL NO.

Phillips

COMPANY

NORTH NW SW SE

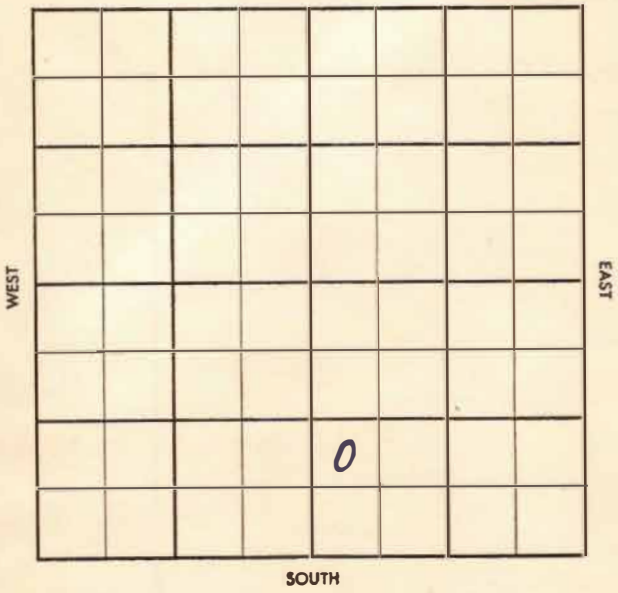

FORM 504-S SUNRAY

S-513-A

CO. Stafford ELEV. 1923 Est

SEC. 9 TWP. 25 RGE. 14W

COMPANY Phillips NO. 2

COMPLETE
DEC 4 '57

FARM Hammond "A"

LOC. NW SW SE

Ank 898

GEOL.

CONTR. Garvey 22#

POOL Hammond

SPUD 10-11-57

8⅝ 270/220

Ank 898 ℙ 2090

X 5½"

3977

X

HL 3525

TR 3558 DG 3577 BL 3687
Log 3207 Bkc 3925 TD 3977
5½ 3977 20/3927-32
4/3947-48 $ 12Bw nt
gg 20/3925-30 $ 8 gw SO
lhn CO 3948 $ 11½ gw lhn
sli oil (½) F10 111BO nt.
+58w pb 1Bo P 3886
24/3844-52 (½) $ 227BO
+ 15Bw

DEC 4 '57 Ppot 456BOpd
+ tr water

CO.
LSE.
NO.
SEC.
TWP.
RGE.

2-12

S-513.A

CO. Stafford ELEV.

SEC. 9 TWP. 25 RGE. 14W

COMPANY Phillips NO. 2

FARM Hammond "A"

LOC. NW SW SE

GEOL.

CONTR. Garvey

POOL Hammond

SPUD 10-16-57

			FIRST REPORT
		OCT	9 57
			0

CO.

LSE.

NO.

SEC.

TWP.

RGE.