

Section 6 Township 25 Range 14W

Well No. 1 Wilson

Company Westgate-Greenland

NORTH

						D	

WEST

EAST

SOUTH

Stafford

KANSAS ✓

Sec. 6 Twp. 25 R. 11W

Well No. #1 Wilson Farm

Westgate-Greenland Company

Westgate-Greenland Contractor

Wildcat


990 Ft. from N. Line

Ft. from S. Line

990 Ft. from E. Line

Ft. from W. Line

SW NE NE

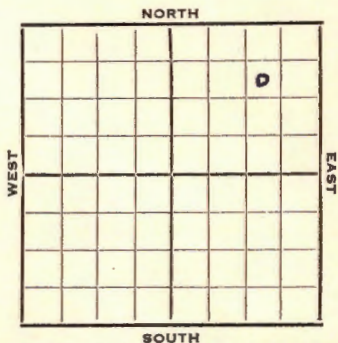

1952 Elev. 2003' REPORT

12/10 Spud 12-5-52  
8" @ 222  
Drig. 2090'

12/11 Ø2090

12/18 Ø4155 Tite Hole

12/23 Spud 12-5-52 D & A TD 4440'  
8" @ 222 Heeb 3581' Br. line 3719'  
Lans. 3752'  
DST 3881-3938 open 1 hr. rec 85' mud  
1250# B KC 4031' Cong. 4129'  
Miss. 4141 Kh. 4151' Viola 4207'  
Simp. 4347' Arb. 4396'  
TD 4440' D & A

**ABANDONED**

County **Stafford** State **Kansas**

Sec. **6** (Blk. Twp.) **2 5** (Sur. Rge.) **14W** Map No.

Operator **Westgate-Greenland**

Well No. **1** Farm **Wilson**

Elev. Location **SW NE NE**


**FIRST REPORT**

**990** Ft. From **N** Line **NE**

**990** Ft. From **E** Line **Quarter**

Ist. Report **DEC 10 1952**

Completion

Remarks

**Westgate-Greenland - Contr.**

Spudding Date **12-5-52**

Orig. Data **Wildcat**

**8" @ 222 drlg. 2090**


County Stafford State Kansas

Sec. 6 (Bk. 25) (Sur. 14W) (Rge.) Map No.

Operator Westgate-Greenland

Well No. 1 Farm Wilson

Elev. 2003 Location SW NE NE

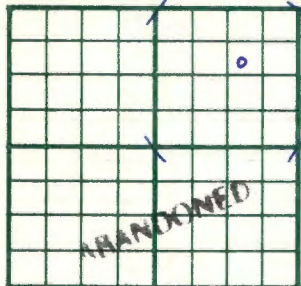

990 Ft. From N Line NE

990 Ft. From E Line Quarter

1st. Report

Completion DEC 23 1952

Remarks Wildcat

Westgate-Greenland - Contr

Spudding Date 12-5-52

Drig. Data D & A TD 4440

8" @ 222 Heeb. 3581 Br. lime 3719

Lans. 3752 DST 3881-3938 open 1 hr.

Rec. 85' mud 1250# B KC 4031

Cong. 4129 Miss. 4141 Kh. 4151

Viola 4207 Simp. 4347 Arb. 4396

TD 4440

D & A