


STAFFORD

DX 78-1

KANSAS

Section 8 Township 25S Range 14W
Well No. #1 Bear
Company Apache Oil Co.

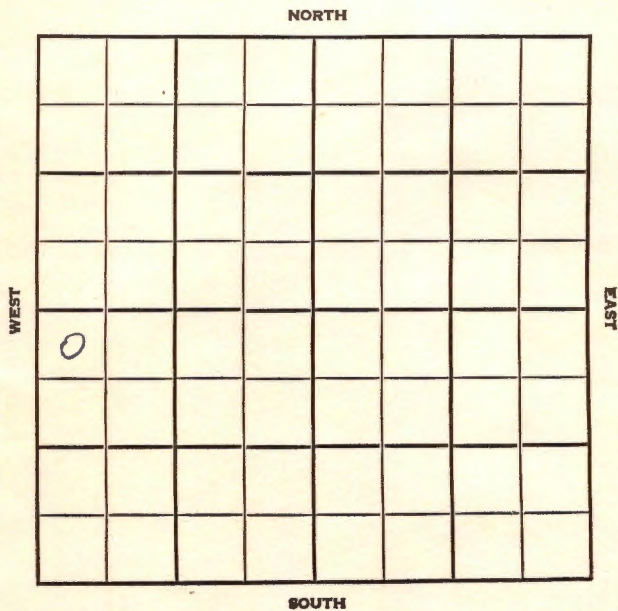

Stafford

KANSAS

SEC.

TWP.

R.

8

25S

14W

WELL NO.

1 Bear

FARM

COMPANY

Apache Oil Co.

CONTRACTOR

Welch & Olsoon Rig #1

Moody

FT. FROM N. LINE

FT. FROM S. LINE

FT. FROM E. LINE

FT. FROM W. LINE

NW NW SW

NORTH									
SOUTH									

WEST

EAST

9

ELEVATION

1956

1990'

REPORT

6-20

Comm. 6-13-56
 8" @ 237 w/200
 Drlg. 3240'

8-29

DST 3910-20 op 1 hr., rec. 170' MSW,
 1340/20".
 5 1/2" @ 4265
 16/4160-56
 B/ 4 GM; 104/4130-56
 48/4173-83
 Flwd 11 BOPD / tr. wtr., died
 P/ 70 BOPD no wtr.
 P/ 18.72 BO / 1/2 BW, 24 hrs.
 P/ 10 BOPD / 30% wtr., Grav. 39°
 Anh. 910'; H. 3573'; Tr. 3594';
 Dg. 3613'; BL. 3713'; L. 3742';
 K. 4156'; V. 4204'; A. 4402';
 TD 4435'

COMPLETED

County Stafford Elev. _____
 Sec. 8 Twp. 25S Rge. 11W
 Company Apache Oil Co.
 Farm Name Bear No. 1

TOPS	DEPTH	LOG	DATUM	Loc. in Sec.
Anh.				NW NW SW
Tr.				
H.				
Tr.				
Dg.				
Bl.				
L.				Geol.
K.C.				Contr. <u>Welch &</u>
B.K.C.				<u>Olsson rigl</u>
Ce.				Pool
C.				<u>Moody</u>
M.				
M.				
K.				
Mz.				
Me.				
V.				
S.				
S.				
A.				
R.				
Pe.				
G.				
T.D.				

FIRST REPORT

Date Comm. 6/13/56
8" 237 w/200, D 3240

JUN 20 '56

JUN 5 1956

County Stafford Elev. 1990
 Sec. 8 Twp. 25S Rge. 11W
 Company Apache Oil Co.
 Farm Name Bear No. 1

TOPS	DEPTH	LOG	DATUM	Loc. in Sec.
Anh.	910			NW NW SW
Tr.				
H.	3573			
Tr.	3594			
Dg.	3613			
Bl.	3713			
L.	3742			
K.C.				Geol.
B.K.C.				Contr. Welch
Ce.				Olsson rig
C.				
M.				Pool
M.				Moody
K.	4156			
Mz.				
Mo.				
V.	4204			
S.				
S.				
A.	4402			COMPLETE
R.				
Pe.				
G.				
TD	4435			

AUG 9 1956

Date Comm. 6/12/56

8" 237 W/200, D 3240 JUL 27 '56 DST

3910-20 1hr run 170' MSW

1340/20" @ 4272 JUL 3 '56 JUL 11 '56

5 1/2 4265/

16/4160-64 @ 4 GM (SSO)

104/4130-56 FRAC JUL 18 '56

48/4173-83 FRAC

AUG 1 '56

AUG 8 '56 Flwd 11 Bopd + Tr. wth

died POP P. 70 Bopd no/w

P. 18.72 DO + 1/2 BW

24 hrs

AUG 15 '56

AUG 22 '56

AUG 29 '56

Ph. P. 10 BORD + 3090

wtr grav 39°