

KANSAS


Stafford

FORM 51 5M 1-42 PETROL

Section 10 Township 25 Range 14-W

Well No. #1 Toland

Company ~~Fred Rust~~ Lion Oil

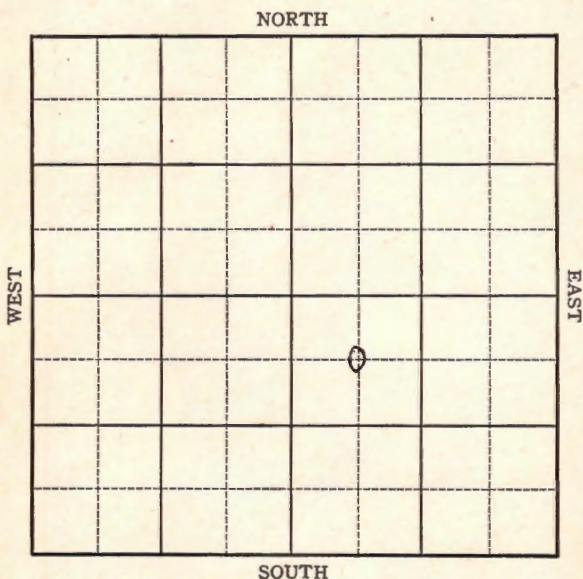

KANSAS

Stafford

Sec. 10 Twp. 25 R. 14-W

Well No. #1 Toland Farm

~~Fred Rust~~ Lion Oil & Refining Company

Wildcat


660 Ft. from N. Line

_____ Ft. from S. Line

_____ Ft. from E. Line

660 Ft. from W. Line

Elco. 1960

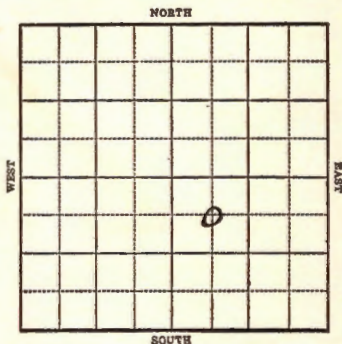

1943

R E P O R T

3/17 Location.

3/24 "

3/31 Drk.

4/7 8" @ 330' WOC.

4/14 Drlg. 3085'

4/21 **Lans 3679**
Drlg. 4035'

4/28 **Viola 4143**
Simp 4296
Arb. 4359
T.D. 4464'
No shows.

ABANDONED

Stafford

KANSASMap No. 83 Sec. 10 Twp. 25 R. 14WWell No. 1 TolandFred Rust Company
FIRST REPORT

Contractor

C NW SE

SECTION PLAT

660 Ft. from N. Line Ft. from S. Line Ft. from E. Line660 Ft. from W. Line

		o	

WILDCAT

Location XXXRig up

Drilling and Remarks:

RECORD

Cased in., ft.Sand Gas Oil Total Depth

PRODUCTION

1st 24 hrs. Nat. 1st 24 hrs. after shot Gas Cu. Ft.Dry Hole Abandoned

Date

MAR 17 194319S. J. LEWIS Scout

Stafford

KANSAS
 Map No. 83 Sec. 10 Twp. 25 R. 14W


Well No. 1 Toland

Lion Oil & Refining Company

CORRECTION Contractor

C NW SE

SECTION PLAT

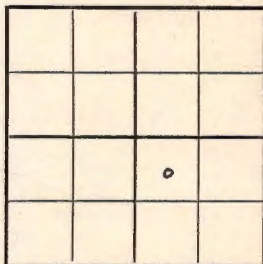660 Ft. from N. Line Ft. from S. Line Ft. from E. Line660 Ft. from W. Line

WILDCAT

Location Rig up Drilling and Remarks: Reported as

Fred Rust

RECORD

Cased in., ft.Sand Gas Oil Total Depth

PRODUCTION

1st 24 hrs. Nat. 1st 24 hrs. after shot Gas Cu. Ft.Dry Hole Abandoned

Date

APR 2 1943 19

S. J. LEWIS Scout

KANSAS

Stafford

Map No. 53 Sec. 10 Twp. 25 R. 14WWell No. 1 TolandLion Oil & Refining CompanyABANDONED

Contractor

C NW SE

SECTION PLAT

660 Ft. from N. Line Ft. from S. Line Ft. from E. Line660 Ft. from W. Line

		6	

WILDCATLocation Rig up

Drilling and Remarks:

*Viola 4143**Quip 4296**Qu 4359**Noe house*

RECORD

Cased in., ft.Sand Gas Oil Total Depth 4464

PRODUCTION

1st 24 hrs. Nat. 1st 24 hrs. after shot Gas Cu. Ft.Dry Hole Abandoned

Date

APR 28 1943 19S. J. LEWIS Scout