

Section 10 Township 25 Range 14 W

Well No. # 2 Toland

Company Helmerich & Payne

NORTH

					0		

WEST

EAST


SOUTH

Stafford

KANSAS ✓

Sec. 10 Twp. 25 R. 14WWell No. #2 Toland FarmHelmerich & Payne CompanyLewis Drlg. Contractor330 Ft. from N. Line Ft. from S. Line Ft. from E. Line990 Ft. from W. Line

NE NW NE

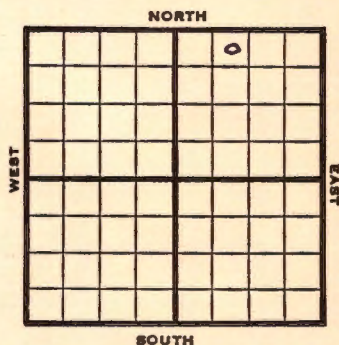

1953 Elev. 1959'

REPORT

6/17 M I R

6/24 8" @ 875
Anhy 860
Drlg. 3521'

7/1 Spud 6-16-53

D & A

TD 4215'

8" @ 875'

Anhy 860, Heeb 3527, Br. Lime 3671,
Lans 3698, Viola 4163

DST 4160-4215, opn 1 hr, rec 30' mud

TD 4215'

D & A

ABANDONED

County Stafford State Kansas
 Sec. 10 (Blk.) 25 (Sur.) 14W Map No.
 Operator Helmerich & Payne
 Well No. 2 Farm Toland
 Elev. _____ Location NE NW NE

FIRST REPORT

330 Ft. From N Line NE
990 Ft. From W N Line Quarter
 1st. Report JUN 17 1953
 Completion _____
 Remarks _____
Lewis Drlg. - Contr.
 Spudding Date _____

Drlg. Data

N I R

J. G. McGEHEE


Sec. 10 (Blk. Twp.) 25 (Sur. Rge.) 14W Map No.

Operator Helmerich & Payne

Well No. 2 Farm Toland

Elev.	1959	Location	NE	NW	NE
-------	------	----------	----	----	----

0

ABANDONED

330Ft. From N Line NE

990 Ft. From W Line Quarter

1st. Report

Completion JUL 1 1953

Remarks

Lewis Drlg. - Contr.

Spudding Date 6-16-53

Drig. Data D & A TD 4215

8" @ 875 Anhy 860 Heeb. 3527

Br. lime 3671 Lans. 3698 Viola 4163

DST 4160-4215 open 1 hr. Rec. 30' mud

TD 4215

D & A

J. G. McGEHEE.