


Section 11 Township 25 Range 14W

Well No. 2 Bair

Company Welsch & Olson Drlg.

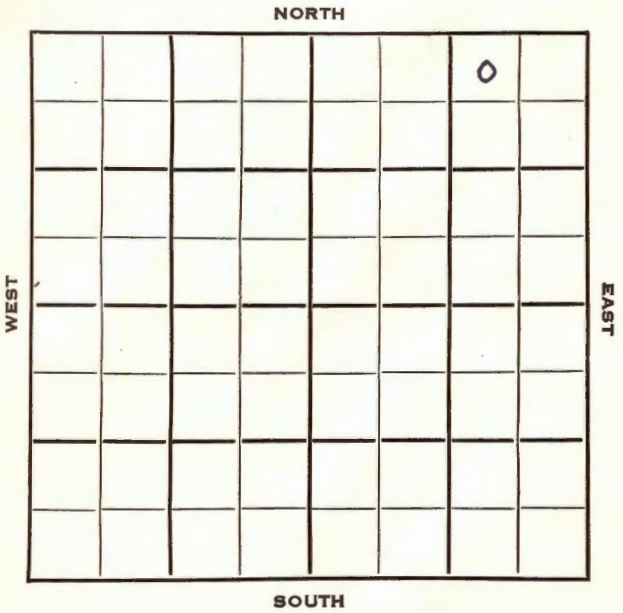

Stafford

KANSAS

SEC.	TWP.	R.
11	25	14 W ✓

WELL NO. # 2 Bair FARM

COMPANY Welsch & Olson Drlg.

CONTRACTOR

Cephas Pool


330 Ft. from N. Line

Ft. from S. Line

990 Ft. from E. Line

Ft. from W. Line

NW NE NE

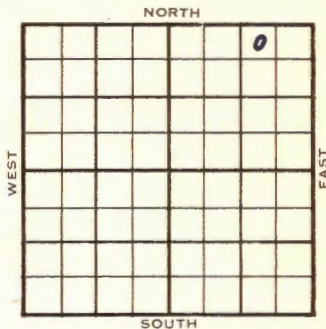

1953	ELEVATION 1958'	REPORT
------	--------------------	--------

9/16 Spud 8-12-53
8" @ 272 Anhy 862
Shut down @ 1385

9/23 Drlg 3649'

9/30 Heeb 3507' Tor 3527' Br 11 3646'
Lans 3677'
DST 3700-3712', 1/2 hr, 30' SO &
GCM, 120' gas. Miss 4039'
KH 4071' V 4122'
DST 4123-50, 1 hr, 80' oil
180' M & GCO 1440#
DST 4150-72, 1 hr, 30' M
TD 4224' 5" @ 4223'

10/7 N.R.

10/14 CO 4156
24/ 4138-44 500 A S/ 1 boph PB 4135
8/ 4133-35 500 A S/ 1 boph 40/
4123-33 2500 A S/ 3 boph CO 4144
S/ 2 1/2 boph / SSW

1954
2/3 Spud 8-12-53
Oil Well
TD 4224'

OVER

1954

2/3

8" @ 272'

Anhy 862', Heeb 3507', Tor 3527',

Br. Lime 3646', Lans 3677',

DST 3700'-12' opn $\frac{1}{2}$ hr, rec 30' so &
gcm, 120' gas, Miss 4039', Kh 4071'

Viola 4122',

DST 4123'-50' opn 1 hr, rec 80' Oil
180' mud & gco 1400#

DST 4150'-72' opn 1 hr, rec 30' Mud

TD 4224'

5" @ 4223'

CO to 4156'

24/ 4138-44 500 A S/ 1 boph PB 4135

8/ 4133-35 500 A S/ 1 boph 40/ 4123-

33 2500 A S/ 3 boph CO to 4144 S/

$2\frac{1}{2}$ bpph SSW

Comp 35 bopd.

COMPLETED

County Stafford State Kansas

Sec. 11 (Blk.) 25 (Sur.) 14W Map No.

Operator Welsch & Olson Drlg.

Well No. 2 Farm Bair

Elev. _____ Location NW NE NE

					0

330 Ft. From N Line NE

990 Ft. From E Line Quarter

1st. Report SEP 16 1958

Completion _____

Remarks _____

Spudding Date 8-12-53

Drlg. Data Cephias Pool

8" @ 272 Anhy 862 shut down @ 1385

