


Stafford **KANSAS**

SECTION 9 TOWNSHIP 25 RANGE 14W

WELL NO. #1 Hammond "A"

COMPANY Phillips Petroleum

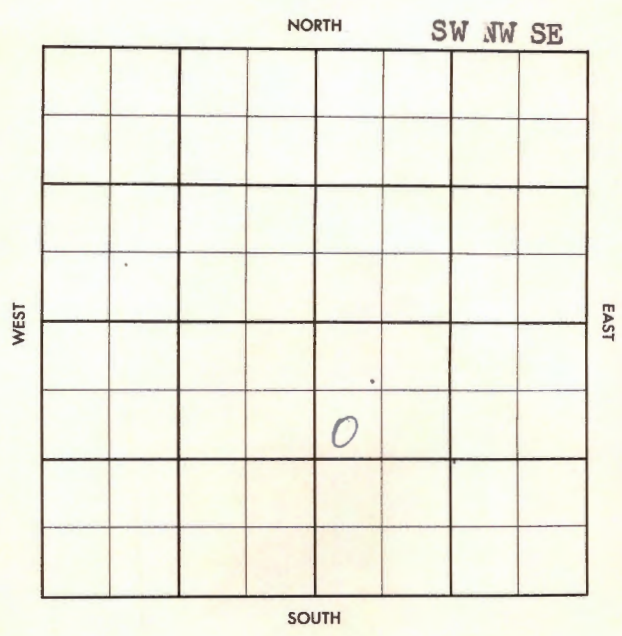

County Stafford Elev. \_\_\_\_\_  
 Sec. 9 Twp. 25 Rge. 14W  
 Company Phillips Petroleum  
 Farm Name Hammond "A" No. 1

TOPS	DEPTH	LOG	DATUM	Loc. in Sec.
Anh.				SW NW SE
Tr.				
H.				
Tr.				
Dg.				
Bl.				
L.				Geol. _____
K.C.				Contr. _____
B.K.C.				
Ce.				
C.				
M.				Pool
M.				<u>Hammond</u>
K.				
Mz.				
Me.				
V.				
S.				
S.				
A.				
R.				
Pe.				
G.				
T.D.				

JUL 31 57  
 FIRST REPORT  
 0

Date Comm. \_\_\_\_\_  
 Location \_\_\_\_\_

~~26~~

Co.  
 Lge.  
 No.  
 Sec.  
 T.  
 R.

County Stafford Elev. 1971  
 Sec. 9 Temp. 25 Y. 14W  
 Company Phillips Petroleum  
 Farm Name Hammond "A" No. 1

TOPS	DEPTH	LOG	DATUM
Anh.			
Tr.			
Dg.			
Bl.		3534	
L.		3679	
K.C.		3706	
B.K.C.		3970	
Ce.			
C.			
M.			
M.			
K.			
Mz.			
Ma.			
V.			
S.			
S.			
A.			
R.			
PE.			
G.			
TD.	3983 1/2		

Loc. in Sec. SW NW SE  
 Geol. \_\_\_\_\_  
 Contr. \_\_\_\_\_  
 Pool Hammond  
 COMPLETE  
 OCT 9 57

Date Comm. \_\_\_\_\_  
 Location AUG 6 57 P-2-57 858 263  
1220 1/2 2560. AUG 14 57 5 1/2 3979/35  
AUG 21 57 C0 3950 12 3923-26 5.121 BOT 14 BW  
3 hrs 5 10.53 BOT 0 X 4 hrs 12 3924-27 1/2 5 FI  
4 1/2 BOT 0 X 1 hr 5 64.55 BOT 0 X 5 hrs Plug 3905  
36 3872-81 36 3871-80 S.O. 1/2 5 28.95 BOT  
85 1/6 BW/32 hrs 5 1/2 PFS 3872-81 AUG 28 57  
SEP 4 57 C0 3905 + 57 day  
PB 3967 32/3831-49 \$ 50 + 7 GW

9-25-14W

FORM 513-1 SUNRAY

14 hrs 300A Flo 60 $\frac{1}{2}$  BO Gr 42.2°  
CO 3948 POP P 200 BO + 27 BW  
in 20 hrs, TP 35<sup>th</sup> CPO<sup>th</sup> P 137 BO  
+ 30 BW 22 hrs SD for repairs

SEP 18 '57 59D 3871 CO 32/384  
- 49 3) Flwhd 115 BO/40°  
Flw 60.5 new oil CO  
3948 P 200 BO 27 BW  
24 hrs SEP 25 '57

gr 34.7° OCT 2 '57 OCT 9 '57 X

340 BO + 5° 70 W  
gr 34°

3841 - 3927

9-25-14W

sw. mit se