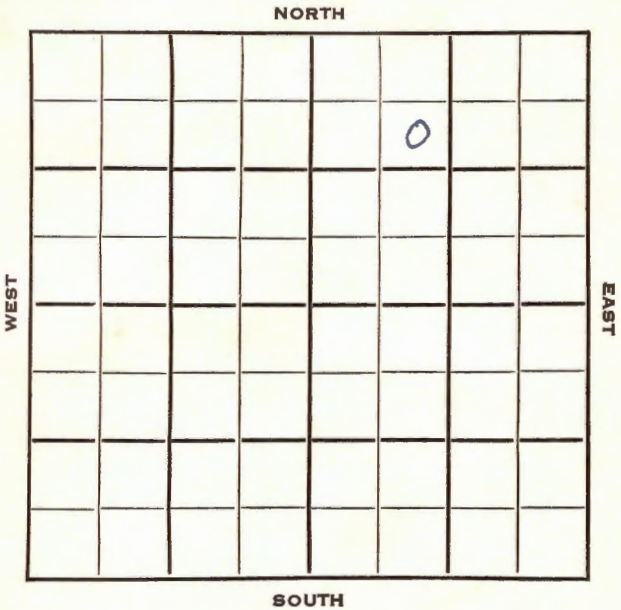


FORM 51

Section 11 Township 25 Range 11WWell No. #3 BairCompany Welsch & Olson Drlg.

Stafford

KANSAS

SEC.	TWP.	R.
11	25	14W

WELL NO.

3 Bair

FARM

COMPANY

Welsch & Olson Drlg.

CONTRACTOR

Cephas Pool

990

Ft. from N. Line


Ft. from S. Line

Ft. from E. Line

990

Ft. from W. Line

SE NW NE

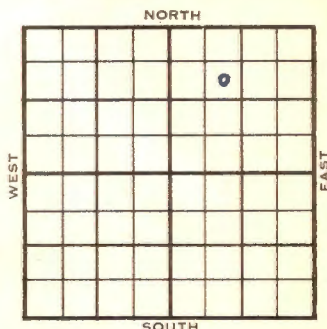

1953

ELEVATION

1960'

REPORT

9/23

Cellar & Pits

9/30

MI

10/7

8" @ 277'

Anhy 855'

Drlg 3278'

10/14

Spud 9-29-53

D & A

TD 4200'

8" @ 277'

Anhy 855, Heeb 3510, Tor 3530, Br.

Lime 3650, Lans 3680, B KC 3970, Miss

4041, Kh. 4070, Viola 4124,

DST 4126-47' opn 1½ hr, rec 35' mud 140#

DST 4147'-80' opn ½ hr, rec 35' mud 0#

TD 4200'

D & A

ABANDONED

County **Stafford** State **Kansas**Sec. **11** (Blk.) **25** (Sur.) **14W** Map No.Operator **Welsh & Olson Drlg.**Well No. **3** Farm **Bair**Elev. **1960** Location **SE NW NE**

			0		

FIRST REPORT

990 Ft. From **E** Line **NW****990** Ft. From **W** Line Quarter1st. Report **SEP 23 195**

Completion

Remarks

Spudding Date

Drlg. Data **Cephas Pool****Cellar & pits**

County Stafford State Kansas
 Sec. 11 (Blk.) 25 (Sur.) 14W Map No.
 Operator Walsch & Olson Drlg.
 Well No. 3 Farm Bair
 Elev. 1960 Location SE NW NE



990 Ft. From N Line NE
990 Ft. From W Line Quarter

1st. Report

Completion OCT 14 1952

Remarks Cephas Pool

Spudding Date 9-29-53

Drlg. Data D & A TD 4200

8" @ 277 Anhy 855 Heeb. 3510

Tor. 3530 Br. line 3650 Lans. 3680

B KC 3970 Miss. 4041 Kh. 4070

Viola 4124 DST 4126-47 open 1½ hr.

Rec. 35' mud 140# DST 4147-80

open ½ hr. Rec. 35' mud 0# TD 4200

D & A

J. G. McGEHEE