

Section 11 Township 25 Range 14 WWell No. # 2 CephasCompany Phillips Pet.

NORTH

WEST

EAST

			0				

SOUTH

Stafford

KANSAS

Sec. 11 Twp. 25 R. 14WWell No. #2 Cephas Farm

Phillips Pet. Company


Phillips
Cephas Pool Contractor330 Ft. from N. Line

Ft. from S. Line

330 Ft. from E. Line

Ft. from W. Line

NE NE NW

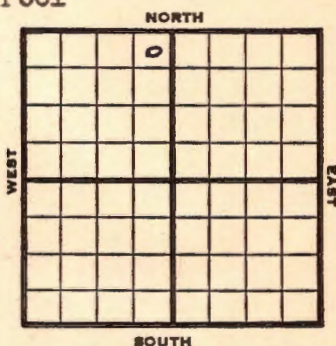

1953 Elev. 1961' REPORT

6/17 Loc.

6/24 10" @ 876'

7/1 Heeb 3501 Tor 3639 Doug 3541
 Br 11 3639 Lans 3667 B KC 3948
 Miss 4029 KH 4039
 Drlg. 4062

7/8 V 4097
 Drlg. 4272'

7/22 N.R.

7/29 Spud 6-18-53

Gas Well

TD 4300

10" @ 876

Heeb 3501, Tor 3519, Doug 3541, Br
 Im 3639, Lans 3667, B KC 3948, Miss 4029,
 Kh 4039, Viola 4097, Simp sh 4252,
 Simp sd 4270, Arb 4292

DST 4292-4300, opn 1 hr., rec. 540'
 sul wtr., 1440#

TD 4300

7" @ 4295

CO to 4288, 60/4148-63, 176/4098-4142,
 4000A, F/1¼ boph, F/3 bo 2nd hr.

892,000 cfg

Comp. for shut in gas well 1½ mcfcpd

COMPI ETED

County **Stafford** State **Kansas**Sec. **11** (Blk.) **25** (Sur.) **14W** Map No.Operator **Phillips Pet.**Well No. **2** Farm **Cephas**Elev. Location **NE NE NW**

330 Ft. From **N** Line **NW****330** Ft. From **E** Line Quarter1st. Report **JUN 17 1953**

Completion

Remarks

Phillips - Contr.

Spudding Date

Drig. Data **Cephas Pool****Location**

County Stafford State Kansas
 Sec. 11 (Blk. 25 (Sur. 14W Map No.
 Operator Phillips Pet.
 Well No. 2 Farm Cephas
 Elev. 1961 Location NE NE NW

			0			

COMPLETE

330 Ft. From N Line NW
330 Ft. From E Line Quarter

1st. Report

Completion JUL 2 9 1953

Remarks Cephas Pool

Phillips - Contr.

Spudding Date 6-18-53

Drig. Data Gas well TD 4300

10" @ 876 Heeb. 3501 Tor. 3519

Doug. 3541 Br. lime 3639 Lans. 3667

B KC 3948 Miss. 4029 Kh. 4039

Viola 4097 Simp. sh. 4252 Simp. sd. 4270

Arb. 4292 DST 4292-4300 open 1 hr.

Rec. 540' sul. str. 1440# TD 4300

7" @ 4295 CO to 4288 60/ 4148-63

176/ 4098-4142 4000 A F/ 1 1/4 boph

F/ 3 bo 2nd hr. 892,000 c/g

Comp. for shut in gas well 1 1/2 mcfgpd