


Section 13 Township 25 Range 14-W

Well Number 1 - Kathelman

Company Atlantic

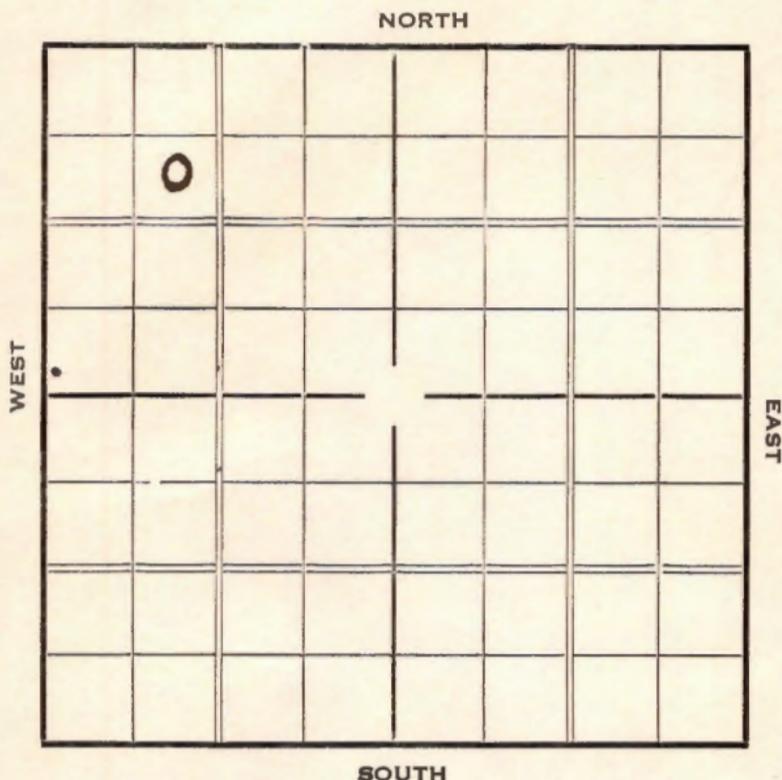

Sec. 13 Twp. 25 R. 14-W

Well No. #1 Katchelman Farm

Atlantic Company


990 Ft. from N. Line

_____ Ft. from S. Line

_____ Ft. from E. Line

990 Ft. from W. Line

NORTH

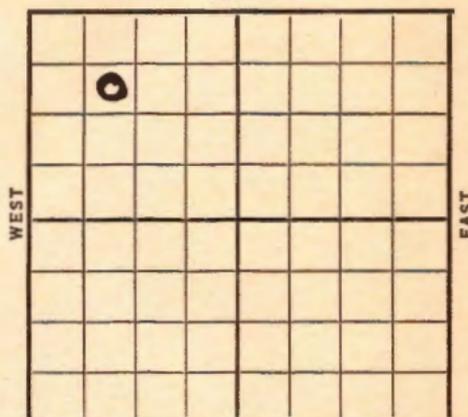

SOUTH

Special

Date	Elev. 1965	REPORT
1937		
5/19		Rot. rig.
5/28		" "
6/4		10" @ 542'. Drlg. 1122'.
6/11		Drlg. 3160'.
6/19		Lans. 3710'. Drlg. 3915'.
6/25		Viola 4175'. Simp. 4256'.
		Sil. 4324'. T.D. 4333' S.W.
6/30		Sil. 4324'.
		T.D. 4340'.
		ABANDONED

Stafford **KANSAS**

Map No. 83 Sec. 13 Twp. 25 R. 14^W

Well No. 1 - Katchelman
Atlanti Company

Contractor

FIRST REPORT

SECTION PLAT

990 Ft. from N. Line
 Ft. from S. Line
 Ft. from E. Line
990 Ft. from W. Line

0			

Location _____

Rig up _____

Drilling and Remarks:

Rot Rig

RECORD

Cased _____ in., _____ ft.
Sand _____
Gas _____
Oil _____
Total Depth _____

PRODUCTION

1st 24 hrs. Nat. _____
1st 24 hrs. after shot _____
Gas _____ Cu. Ft.
Dry Hole _____
Abandoned _____

Date

MAY 19 1937 19

H. D. Hatfield

Scout

Stafford **KANSAS**

Map No. _____ Sec. 13 Twp. 25 R. 14 ^W

Well No. 1 - Katchelman

atlantic Company

Contractor _____

ABANDONED

SECTION PLAT

0			

990 Ft. from N. Line

_____ Ft. from S. Line

_____ Ft. from E. Line

990 Ft. from W. Line

Location _____

Rig up _____

Drilling and Remarks:

D&A

RECORD

Cased _____ in., _____ ft.

Sand sil 4324

Gas _____

Oil _____

Total Depth 4340

PRODUCTION

1st 24 hrs. Nat. _____

1st 24 hrs. after shot _____

Gas _____ Cu. Ft.

Dry Hole _____

Abandoned _____

Date

JUN 30 1937

19

E. D. Hatfield

Scout