

KANSAS


FORM 51 5M 6-46 PETROL

Stafford County

Section 13 Township 25 Range 14W

Well No. 1 Kachleman

Company Cities Service

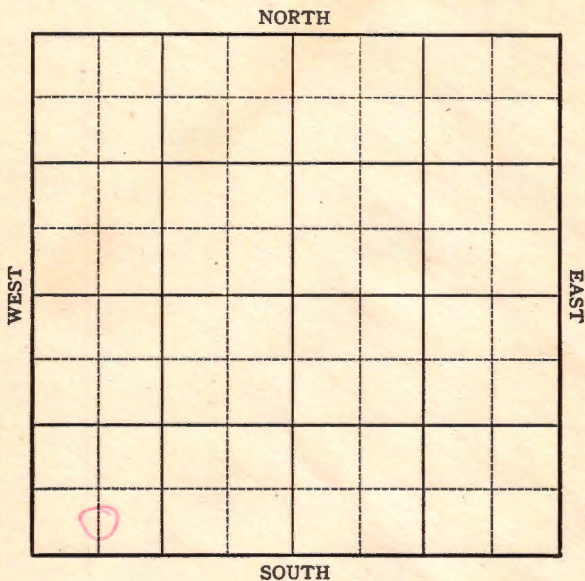

KANSAS

Stafford County

Sec. 13 Twp. 25 R. 14W

Well No. #1 Kachleman Farm

Cities Service Company

Kipp


 Ft. from N. Line

330 Ft. from S. Line

 Ft. from E. Line

660 Ft. from W. Line

CSL SW SW

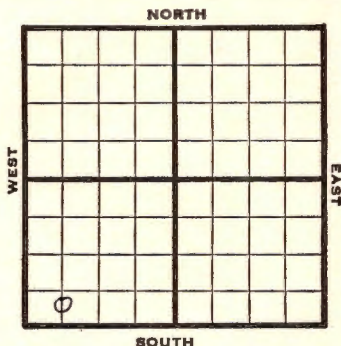

1946

Elev. 1965

REPORT

8/7

Derrick

8/13

8" @ 835'

Dr1g 3120'

8/21

Lans 3680

TD 3990'

ABANDONED

KANSAS

Kansas Pool Name KippMap No. 23 Sec. 13 Twp. 25 R. 14WWell No. 1 KachlemanCities Service


Company

FIRST REPORT

Contractor

C S L SW SW

SECTION PLAT

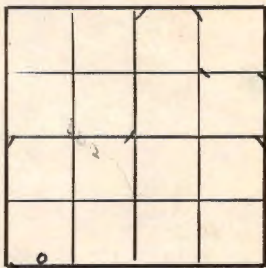Ft. from N. Line330 Ft. from S. LineFt. from E. Line660 Ft. from W. LineStafford County

Location

Rig up

Drilling and Remarks:

Derrick

RECORD

Cased in. ft.

Sand

Gas

Oil

Total Depth

PRODUCTION

1st 24 hrs. Nat.

1st 24 hrs. after shot

Gas Cu. Ft.

Dry Hole

Abandoned

Date

AUG 7 1946 19S. J. LEWIS

Scout

KANSAS

Kansas


Pool Name KippMap No. 83 Sec. 13 Twp. 25 R. 14WWell No. 1 Kachleman

Cities Service Company

ABANDONED

Contractor

C S L SW SW

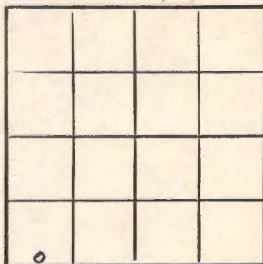E 1/1965
SECTION PLAT Ft. from N. Line330 Ft. from S. Line Ft. from E. Line660 Ft. from W. LineStafford CountyLocation Rig up

Drilling and Remarks:

Home 3680**RECORD**Cased in., ft.Sand Gas Oil Total Depth 3990**PRODUCTION**1st 24 hrs. Nat. 1st 24 hrs. after shot Gas Cu. Ft.Dry Hole Abandoned

Date

AUG 21 1946 19 S. J. LEWIS Scout