


Section 15 Township 25 Range 14-W

Well Number #1 Jordon

Company Empire et al

NORTH SPECIAL

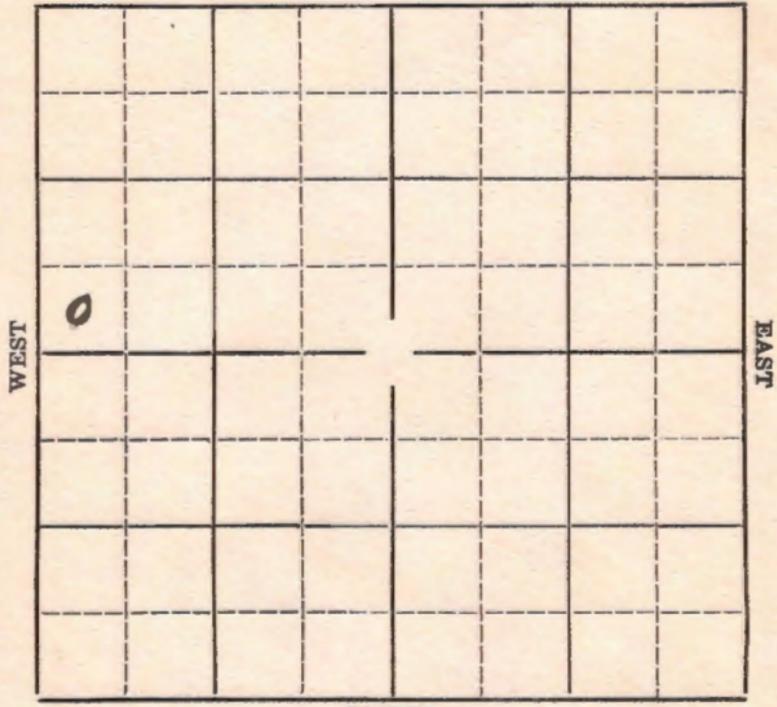

SOUTH

Sec. 15 Twp. 25 R. 14W

Well No. #1 Jordan Farm

Empire et al Company


_____ Ft. from N. Line

330' Ft. from S. Line

_____ Ft. from E. Line

330' Ft. from W. Line

(Special)

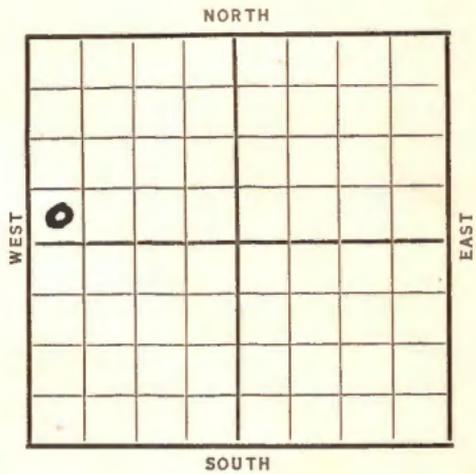

Date 1936 Elev. 1969 REPORT

10/21 Rig.

10/29 15" @ 294'. WOC.

11/6 Drlg. 2392

11/12 Drlg. 3740

11/19 ~~Lansing 3537'~~ 8" @ 3680'.
WOC

12/1 Lansing 3537'. 8" @ 3680'.

Pay 3722-27'. 1600 ft. oil

4 hrs. 2950' oil 5 hrs.

Shut down. Bldg. tankage. (tel)

12/7 Potential Gauge 270 Barrels Oil and
70 Barrels water 24 hours (Telegram)

12/10 29 Gravity.

12/17 2000 acid. Pot 575 oil 2% water.

12/24 6% water.

12/29 ---

1937

1/7 Pot. 575 oil 2% water.

Shut down.

1/14 Rigging up to drill deeper.

1/21 Coring 3802'.

1/28 Drlg. 4045'.

OVER

1937

2/4 Viola 4125'. Coring 4204' show oil.

2/11 Simpson 4210. Sil 4252. SW 4267 Plug back 3943' set 5" WOC

2/18 120 shots 3815-35' hole full oil. Run tubing.

2/26 Swabbed 65 bbls oil 15 bbls. water 3 hrs.

3/4 4000 acid swabb. 127 bbls an hour 33.6 gravity.

3/11 " " " " " "

3/18 Shut Down

3/24 Sil. 4252'.

T. D. 4267'.

P.B. 3943'.

Potential flow 2035, cut 6%.

COMPLETED

Map No. 83 Sec. 15 Twp. 25 R. 14W

Well No. 1 declon

Empire & Co Company

Contractor

Special

SECTION PLAT

_____ Ft. from N. Line

330 Ft. from S. Line

_____ Ft. from E. Line

330 Ft. from W. Line

0			

FIRST REPORT

Location _____

Rig up _____

Drilling and Remarks:

Rig

RECORD

Cased _____ in., _____ ft.

Sand _____

Gas _____

Oil _____

Total Depth _____

PRODUCTION

1st 24 hrs. Nat. _____

1st 24 hrs. after shot _____

Gas _____ Cu. Ft.

Dry Hole _____

Abandoned _____

Date

OCT 21 1936

19

S. J. LEWIS

Scout

KANSAS *Stafford*

Map No. 83 Sec. 15 Twp. 25 R. 14W

Well No. 1 Jordan

Empire & Co. Company

Contractor

SECTION PLAT

_____ Ft. from N. Line

330 Ft. from S. Line

_____ Ft. from E. Line

320 Ft. from W. Line

COMPLETED

Location _____

Rig up _____

Drilling and Remarks:

*Bit 4252
P.B3949*

*Potential flow
2035 cut 6%*

RECORD

Cased _____ in., _____ ft.

Sand _____

Gas _____

Oil _____

Total Depth 7267

PRODUCTION

1st 24 hrs. Nat. _____

1st 24 hrs. after shot _____

Gas _____ Cu. Ft.

Dry Hole _____

Abandoned _____

Date

MAR 24 1937

S. J. LEWIS Scout