

KANSAS

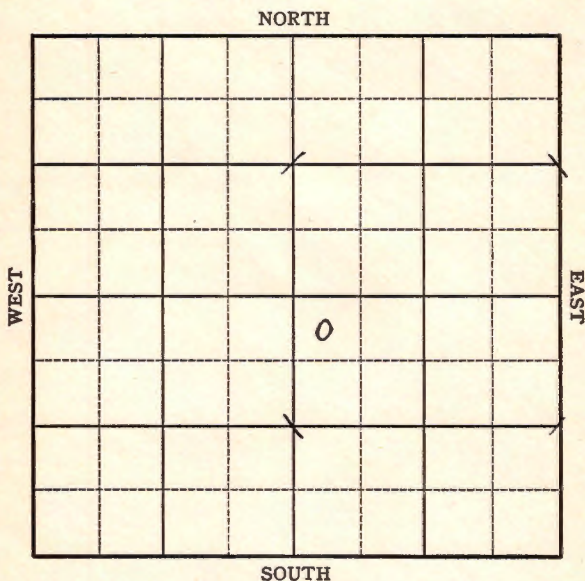
Stafford

FORM 51 5M 10-41 PETROL

Section 15 Township 25 Range 14-W

Well No. #1 Kachelman

Company Aylward Production

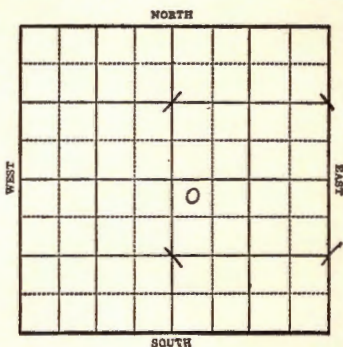


KANSAS

Stafford

Sec. 15 Twp. 25 R. 14-WWell No. #1 Kachelman FarmAylward Production Company

Jordon Pool

330 Ft. from N. Line Ft. from S. Line Ft. from E. Line330 Ft. from W. Line*Elco. 1969*

1943

R E P O R T

3/10 Location

3/17 "

3/24 "

3/31 "

4/7 "

4/14 10" @ 305' fsg. 2200'

4/21 Drlg. 3630'

4/28 **Lans 3690**

T.D. 3898

No shows.

ABANDONED

County Stafford Elev. 1970
 Sec. 75 Twp. 25S Rge. 11W
 Company Cities Service & A+1.
 Farm Name Stimatz No. 1

TOPS	DEPTH	LOG	DATUM	Loc. in Sec.
Ank.				NW NE SW
TP.	3042			
H.	3457			
Tr. <u>3d 854</u>	2826			
Dg. <u>HA</u>	3457			
BL. <u>BE</u>	3427			
L.	3627			
K.C. <u>Dg</u>	3531			Geol.
B.K.C. <u>DL</u>	2601			Contr.
Ce. <u>LS9</u>	3627			Prime Drlge.
C.				
M.				
M.				Pool
K.				
Mr.				Jordan
Mo.				
V.				
S.				
S.				
A.				
R.				
Pe.				
G.				
T.D.	3900			

COMPLETE

OCT 31 '56

Date Comm. 9-28-56

8" L08 w/250; D 2185 OCT 10 '56

DST 2822-62 1hr. see 13' Md

140/30" DST 3652-93 OCT 17 '56

1hr. G/4" see 80' GCM BHP

1325/30 DST 3696-3715 1hr

125' Oil spkd & GCM 300/30

DST 3761-82 1hr 40' Md BHP

270/30 DST 3801-15 1hr 128'

50' GCM + 98' SW 295/30"

DST 3814-40 1hr 45' 50CM

200 / 30" 5' 1/2 @ 3900 / 150

Oct 24 '56 CO' 3835 41 / 3858-60

17 / 3852-56 73 / 3806-24

37 / 3791-3800 33 / 3768-76

37 / 3712-21 26 / 3702-10

12 (3852-68) 12 3806-24

11 3791-3800 11 3768-76

12 3702-10 P. 150 B0

+ 90 BW 20 hrs Pop.

OCT 31 '56 P. 95 B0 + 10 BW in

24 hrs

15-25-14

nw ne sw

Stafford

KANSASMap No. 83 Sec. 15 Twp. 25 R. 14WWell No. 1 Kachelman

Aylward Production

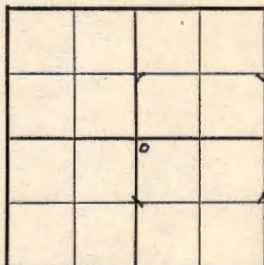
Company

FIRST REPORT

Contractor

NW SE

SECTION PLAT

330 Ft. from N. Line Ft. from S. Line Ft. from E. Line330 Ft. from W. Line

JORDON POOL

Location XXXRig up

Drilling and Remarks:

RECORD

Cased in., ft.Sand Gas Oil Total Depth

PRODUCTION

1st 24 hrs. Nat. 1st 24 hrs. after shot Gas Cu. Ft.Dry Hole Abandoned

Date

MAR 10 1943

19

S. J. LEWIS

Scout

KANSAS

Stafford

Map No. 83 Sec. 15 Twp. 25 R. 14WWell No. 1 KachelmanAylward Production

Company

ABANDONED

Contractor

NW SE

SECTION PLAT

330

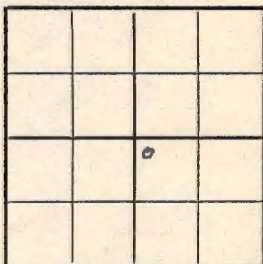
Ft. from N. Line

Ft. from S. Line

Ft. from E. Line

330

Ft. from W. Line

JORDON POOL

Location

Rig up

Drilling and Remarks:

*Lease 3690**No show*

RECORD

Cased _____ in., _____ ft.

Sand _____

Gas _____

Oil _____

Total Depth 3898

PRODUCTION

1st 24 hrs. Nat. _____

1st 24 hrs. after shot _____

Gas _____ Cu. Ft.

Dry Hole _____

Abandoned _____

Date

APR 28 1943 19S. J. LEWIS Scout