


Section 15 Township 25 Range 14-W

Well Number 1 - Stimatze

Company Empire et al

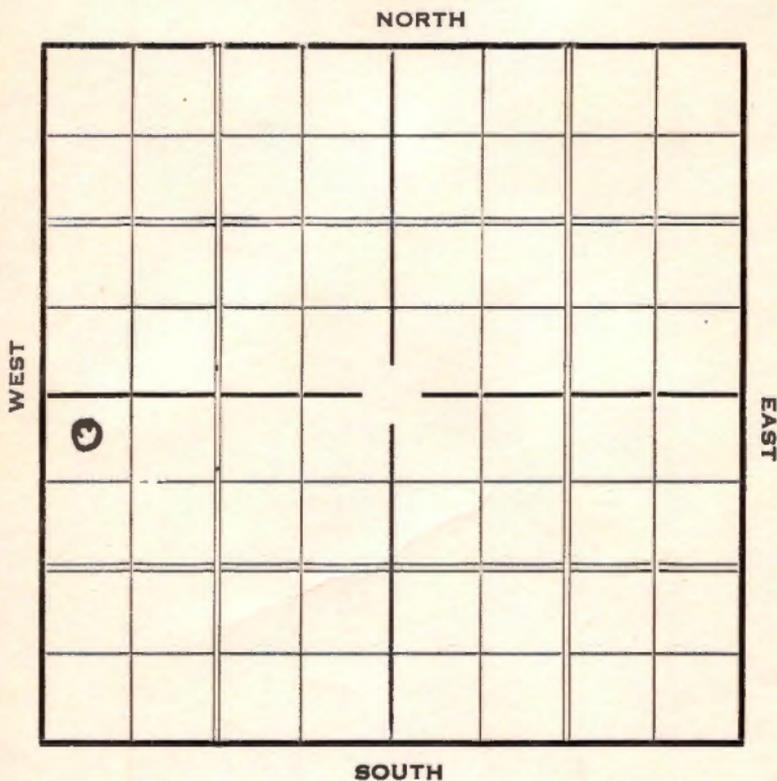

Sec. 15 Twp. 25 R. 14-W

Well No. #1 Stimatze Farm

Empire et al Company


330 Ft. from N. Line

\_\_\_\_\_ Ft. from S. Line

\_\_\_\_\_ Ft. from E. Line

330 Ft. from W. Line

**Elev. 1970**

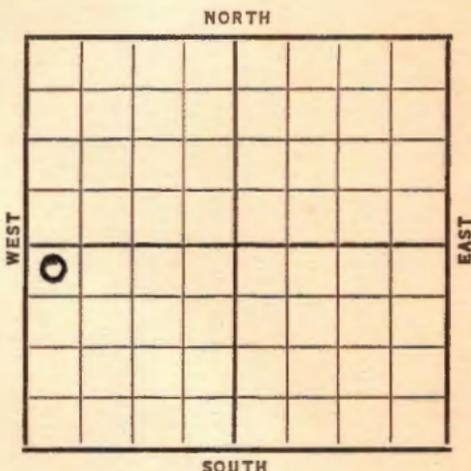

Date	REPORT
1937	
5/12	Location
5/21	12" @ 309'. WOC.
5/28	Anhy 1900'. Drlg. 2200'.
6/4	Drlg. 3433'.
6/11	Lans. 3605'. Pay 3692-3701'.
	T.D. 3802'. S.O. in cuttings
	6" @ 3788'.
6/19	" "
6/25	T.D. 3809'. 4000 acid.
6/30	6" @ 3788'.
	K.C. 3605'.
	T.D. 3809'.
	4000 A.
	Pot. 1088 bbls. Flow.
	<b>COMPLETED</b>

**KANSAS**

*Stafford*

Map No. 83 Sec. 15 Twp. 25 R. 14w

Well No. 1 - Stimatz

Empire et al Company

Contractor

**FIRST REPORT**

**SECTION PLAT**

330 Ft. from N. Line

     Ft. from S. Line

     Ft. from E. Line

330 Ft. from W. Line

0			

Location ✓

Rig up     

Drilling and Remarks:

**RECORD**

Cased      in.,      ft.

Sand     

Gas     

Oil     

Total Depth     

**PRODUCTION**

1st 24 hrs. Nat.     

1st 24 hrs. after shot     

Gas      Cu. Ft.

Dry Hole     

Abandoned     

Date

MAY 12 1937 19

H. D. Hatfield

Scout

Stafford **KANSAS**

Map No. \_\_\_\_\_ Sec. 15 Twp. 25 R. 14 W

Well No. 1 - Stimatz

Empire etal Company  
Contractor

**COMPLETED**

**SECTION PLAT**

330 Ft. from N. Line  
\_\_\_\_\_ Ft. from S. Line  
\_\_\_\_\_ Ft. from E. Line  
330 Ft. from W. Line

0			

Location \_\_\_\_\_

Rig up \_\_\_\_\_

Drilling and Remarks:

4000 A.  
Post - 1988  
flow.

**RECORD**

Cased 6 in., 3788 ft.  
Sand K.C., 3605  
Gas \_\_\_\_\_  
Oil \_\_\_\_\_  
Total Depth 3809

**PRODUCTION**

1st 24 hrs. Nat. \_\_\_\_\_  
1st 24 hrs. after shot \_\_\_\_\_  
Gas \_\_\_\_\_ Cu. Ft.  
Dry Hole \_\_\_\_\_  
Abandoned \_\_\_\_\_

Date

H. D. Hatfield

JUN 30 1937 19

Scout