


Stafford

KANSAS

SECTION 1 TOWNSHIP 25S RANGE 14W

WELL NO #1 Bowker "C"

COMPANY Petroleum Inc.

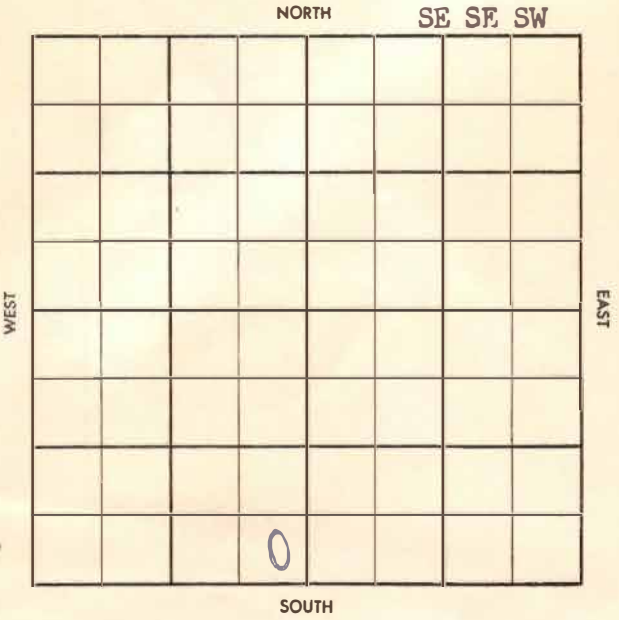

CO. Stafford ELEV. 1957 RB

SEC. 1 TWP. 25 RGE. 14W

COMPANY Petroleum Inc. NO. 1

CO. NO. \_\_\_\_\_  
 SEC. NO. \_\_\_\_\_  
 TWP. NO. \_\_\_\_\_  
 RGE. NO. \_\_\_\_\_  
 OCT 16 57

FARM Bowker "C"

LOC. SE SE SW

Tops	
Anhy	325
H6	3499
B1	3638
L	3664
C	4010
M	4019
K	4050
V	4115
XS	4239
A	4293

GEOL. \_\_\_\_\_  
 CONTR. Garvey Drlg.  
 POOL Semi Wildcat  
 SPUD 9-28-57  
8" @ 265 w/200 drlg.  
2085. OCT 9 57 TOPS  
DST 3673-3746 1hr  
210' wtry M BHP 1160/20  
DST 3797-3815 1hr.  
960' GIP 40' HOCM

RTD 4309 60' OCMdy W BHP 960/20"  
DST 3818 - 3923 1hr 205' wtry M  
BHP 0/20" Tops C 4010 M 4019  
K 4052 V 4115 P 4163  
DST 4125-4208 60" 55' M with spks oil  
BHP 0/20" S 4228 ~~RTD~~ A 4293  
DST 4294 - 99 45" 30' M BHP  
1140/20" DST 4299 - 4309 60"  
1740' SW BHP 1075/20" RTD 4309  
no logs D & A

CO. NO. \_\_\_\_\_  
 SEC. NO. \_\_\_\_\_  
 TWP. NO. \_\_\_\_\_  
 RGE. NO. \_\_\_\_\_

~~26~~

~~13~~

# WILDCAT

S-513.A

CO. ~~Stafford~~ ELEV. \_\_\_\_\_  
 SEC. 1 TWP. 25 RGE. 14W  
 COMPANY Petroleum Inc. NO. 1

FIRST REPORT  
 OCT 2 1957  
 0

FARM Barker "C"

LOC. SE SE SW

Tops	
Anhy	825

GEOL. \_\_\_\_\_  
 CONTR. Garvey Drlg.  
 POOL Semi Wildcat  
 SPUD 9-28-57  
8" O 265 w/220, drlg.  
2085.

CO.  
 LSE.  
 NO.  
 SEC.  
 TWP.  
 RGE.