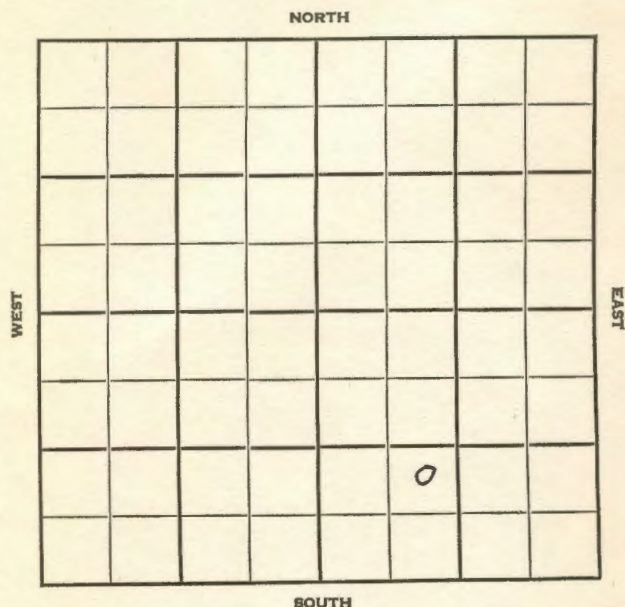


Section 16 Township 25S Range 14WWell No. #4 Neeland BCompany Cities Service & Atlantic

SEC.

16

TWP.

25

R.

14W

WELL NO.

#4 Neeland "B"

FARM

COMPANY

Cities Service & Atlantic

CONTRACTOR

Barbour

Jordan


_____ Ft. from N. Line

_____ Ft. from S. Line

_____ Ft. from E. Line

_____ Ft. from W. Line

NE SW SE

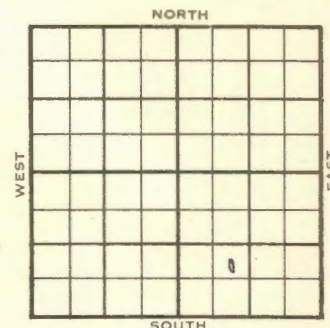

1955

ELEVATION

1971'

REPORT

8-31

MIR

9-14

Comm. 8-30-55

8 5/8" @ 387

DST 3723-42 op 1 hr. rec. 700' gas,
10' socm, 80' mud, 60' muddy wtr.

BHP 610# 30";

DST 3741-76 op 1 hr. rec. 195' msw,
BHP 1080# 30";DST 3775-91 op 30" rec. 15' msw, BHP
1192# 30";DST 3791-3840 op 1 hr. rec. 15' ~~gas~~
gc&socm, 180' gcm, BHP 375# 30";DST 3698-3714 db pck op 1 hr. rec 60
vso & gdm, B P 400# 30";DST 3840-64 op 1 hr. rec. 115' msw,
BHP 640#, no log.

D & A

Tops: H. 3484

B.L. 3624

L. 3651

T.D. 3915'

ABANDONED

County Stafford Elev. 1971
Sec. 16 Twp. 25S Rge. 11W
Company Cities Service & Atlantic
Farm Name Neeland "B" No. 4

TOPS	DEPTH	LOG	DATUM	Loc. in Sec.
Anh.				NE SW SE
TP.				
H.	3484		1513	
Tr.				
Dg.				
BL.	3624		1653	
L.	3651		1680	
K.C.				Geol.
B.K.C.				Contr.
Ce.				Barbour
C.				
M.				Pool
M.				Jordan
K.				
Mz.				
Me.				
V.				
S.				
S.				
A.				
R.				
Pe.				
G.				
TD.	3915			

Date Comm. 8-30-55 SEP 14 1955
8-5/8" 387; DST 3723-42 op 1 hr. rec. 700'
gas, 10' socm, 80' mud, 60' muddy wtr.
BHP 610# 30"; DST 3741-76 op 1 hr rec. 195'
msw, BHP 1080# 30"; DST 3775-91 op 30" rec.
15' msw, BHP 1192# 30"; DST 3791-3840 op
1 hr. rec. 15' gc & socm, 180' gcm, BHP 375#
30"; DST 3698-3714 db pckr op 1 hr. rec. 60'
vso & gcm, BHP 400# 30"; DST 3840-64 op
1 hr. rec. 115# msw, BHP 640#; no log
D & A

County Stafford Elev. 1971
Sec. 16 Twp. 25S Rge. 11W
Company Cities Service & Atlantic
Farm Name Neeland "B" No. 4

TOPS	DEPTH	LOG	DATUM	Loc. in Sec.
Anh.				NE SW SE
TP.				
H.				
Tr.				
Dg.				
BL.				
L.				
K.C.				Geol.
B.K.C.				Contr.
Ce.				Barbour
C.				
M.				Pool
M.				Jordan
K.				
Mz.				
Me.				
V.				
S.				
S.				
A.				
R.				
Pe.				
G.				
TD.				

Date Comm. MIR
26
FIRST REPORT