

DX 78-1


Stafford

KANSAS

Section 17 Township 25 Range 14W

Well No. #1 Hall

Company Alpine Oil & Royalty

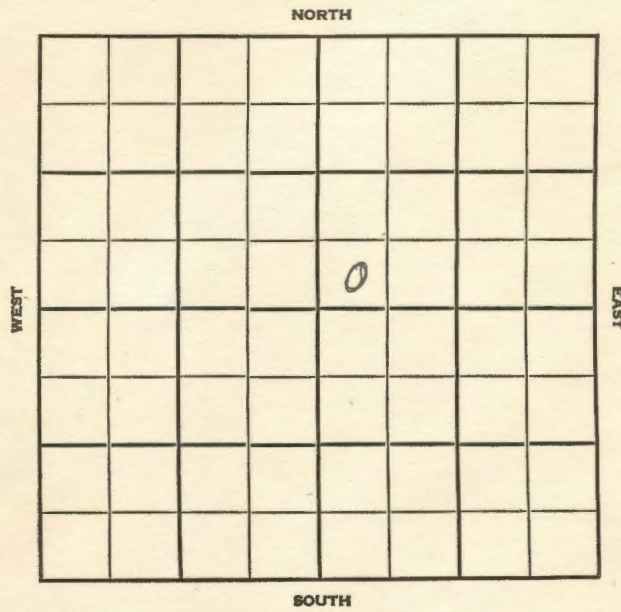

County Stafford Elev. 1986
 Sec. 17 Twp. 25 Rge. 11W
 Company Alpine Oil & Royalty
 FarmName Hall No. 1

TOPS	DEPTH	LOG	DATUM	Loc. in Sec.
Anh.				SW SW NE
TP.				
H.				
Tr.				
Dg.				
Bl.				
L.				
K.C.				Geol.
B.K.C.				Contr.
Ce.				Quaker Drlg.
C.				
M.				Pool
M.				
K.				
Mz.				
Me.				
V.				
S.				
S.				
A.				
R.				
Pe.				
G.				
TD.				

Date Comm. Phillips - DHM
 Location 254/225
 NOV 5 1956
 G. R.

County Stafford Elev. 1986
 Sec. 17 Twp. 25 Rge. 11W
 Company Alpine Oil & Royalty
 FarmName Hall No. 1

TOPS	DEPTH	LOG	DATUM	Loc. in Sec.
Anh.	895			SW SW NE
TP.	3575			
H.				
Tr.				
Dg.		3615		
Bl.	3715	3714		
L.	3745	3745		
K.C.				Geol.
B.K.C.	3999			Contr.
Ce.				Quaker Drlg.
C.	4139	4140		
M.	4169	4169		Pool
M.				
K.	4178			
Mz.				
Me.				
V.	4239	4239		
S.	4368	4368		
S.				
A.	4420	4423		
R.				
Pe.				
G.				
TD.	4470	4471		

Date Comm. Phillips - DHM
 Location 254/225
 11-8-56 858
 254/225 2535 NOV 21 56
 3890 NO. 25 56 DST 4170-80 1km
 rel 12' Md All press 0
 D&A