


Section 21 Township 25 Range 11W

Well No. #1 Stimatz

Company Alpine Oil

NORTH

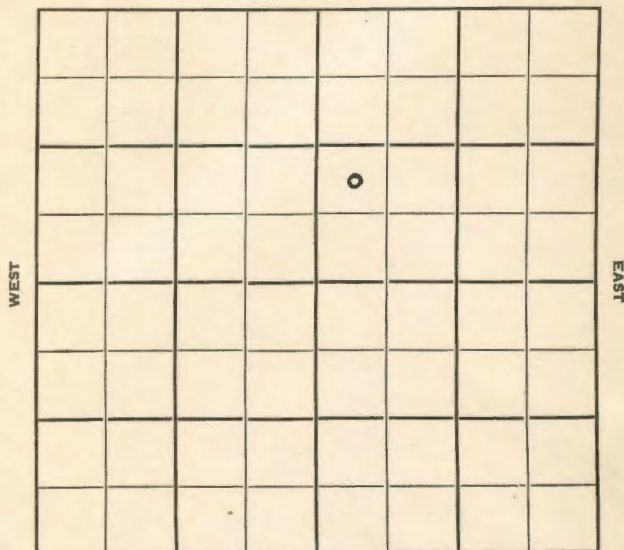

SOUTH

Sec. 21 Twp. 25 R. 11W

Well No. #1 Stimatz Farm

Alpine Oil Company

Contractor

Wildcat

Ft. from N. Line


990 Ft. from S. Line

Ft. from E. Line

330 Ft. from W. Line

NW SE NE

NORTH

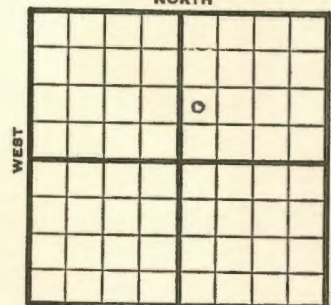

SOUTH

1952 Elev. 1977' REPORT

10/15 Drlg.  
10/22 8" @ 371 Heeb 3514' Br Li 3662'

Lans. 3687'

DST 3752-73, 1 hr, 60' M 975#

DST 3816-36, 1 hr, 50' VSOCM

DST 3896-3920, 1 hr, 90' wtr. plus SSO

Cong. 4050' Miss 4160' V 4189'

Drlg.

10/29 Spud 10-6-52  
D&A TD 4334'  
8" @ 371'

Heeb. 3514 Br Li 3662

Lans. 3687

DST 3752-73 open 1 hr. rec. 60' mud 975#

DST 3816-36 open 1 hr. rec. 50' vsocm

DST 3896-3920 open 1 hr. rec.

90' wtr. &amp; SSO 960#

Cong. 4050 Miss. 4160


Viola 4189 Simp. 4238

Arb. 4309

TD 4334' D&amp;A

ABANDONED

County Stafford State Kansas  
 Sec. 21 (Bk.) 25 (Sur.) 14W Map No.  
 Operator Alpine Oil  
 Well No. 1 Farm Stimatz  
 Elev. 1977 Location NW SW NE

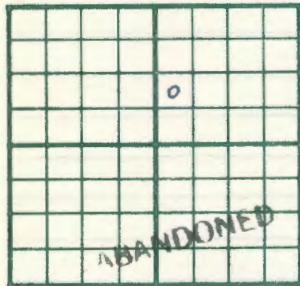

990 Ft. From S Line NE  
330 Ft. From W Line Quarter  
 1st. Report  
 Completion OCT 29 1952  
 Remarks Wildcat


Spudding Date 10-6-52

Drig. Data D & A TD 4334  
8" @ 371 Heeb. 3514 Br. lime 3662  
Lans. 3687 DST 3752-73. open 1 hr.  
Rec. 60' mud 975# DST 3816-36  
open 1 hr. Rec. 50' vsocm DST 3896-3920  
open 1 hr. Rec. 90' wtr. & SSO 960#  
Cong. 4050 Miss. 4160 Viola 4189  
Simp. 4238 Arb. 4309 TD 4334

D & A

J. G. McGEHEE

County Stafford State Kansas  
 Sec. 21 (Bk.) 25 (Sur.) 14W Map No.  
 Operator Alpine Oil  
 Well No. 1 Farm Stimatz  
 Elev. 1977 Location NW SW NE

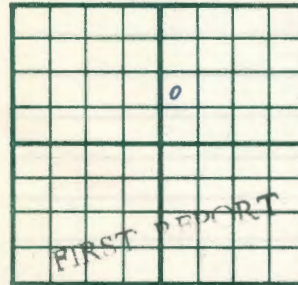

990 Ft. From S Line NE  
330 Ft. From W Line Quarter  
 1st. Report OCT 15 1952  
 Completion  
 Remarks

Spudding Date

Drig. Data Wildcat

drig.

J. G. McGEHEE