



Section 22 Township 25 Range 14-W  
 Well No. #1 Kipp "F"  
 Company Skelly etal.

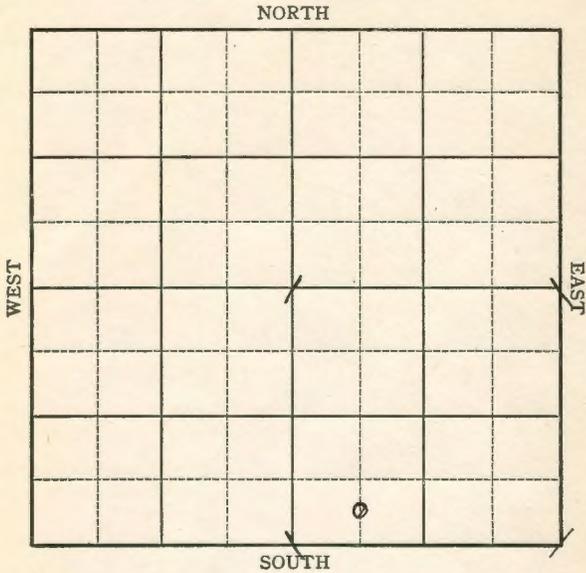

Sec. 22 Twp. 25 R. 14-W  
 Well No. #1 Kipp "F" Farm \_\_\_\_\_  
 \_\_\_\_\_ Skelly etal Company \_\_\_\_\_

Kipp Pool

\_\_\_\_\_ Ft. from N. Line  
330 Ft. from S. Line  
 \_\_\_\_\_ Ft. from E. Line  
660 Ft. from W. Line

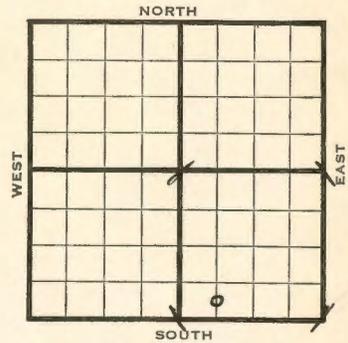

Elev. 1981

1943

REPORT

1/20 Location  
 1/27 "  
 2/3 8" @ 382'  
 Drlg. 2113'  
 2/10 Drlg. 3760'  
 2/17 **Lans 3688**  
**Pay 3824-26**  
 Drlg. 3829.  
 2/24 **Lans 3691 Corrected**  
 5" Casing set 3827  
 TD 3890 SO  
 3/3 " " "  
 3/10 TD 2903' fdg tools.  
 3/17 **Lans 3691**  
 5" @ 3827'  
 T.D. 3907'  
 5000 gal. acid  
 Flow 156 bbls oil  
 3 1/2 M gas Pot.  
 Gravity 34.1

**COMPLETED**

Map No. KANSAS 33 Sec. 22 Twp. 25 R. 14W

Well No. 1 Kipp "F"

Skelly et al. Company

**COMPLETED**

Contractor

C SL SW SE

SECTION PLAT

\_\_\_\_\_ Ft. from N. Line

330 Ft. from S. Line

\_\_\_\_\_ Ft. from E. Line

660 Ft. from W. Line


KIPP POOL

Location \_\_\_\_\_

Rig up \_\_\_\_\_

Drilling and Remarks:

*Lease 8691*  
*5-23822*  
*5000 cu ft*  
*Flow 156 cu ft*  
*3 1/2 M Gas Per.*  
*24-32*

RECORD

Cased \_\_\_\_\_ in., \_\_\_\_\_ ft.

Sand \_\_\_\_\_

Gas \_\_\_\_\_

Oil \_\_\_\_\_

Total Depth 3307

PRODUCTION

1st 24 hrs. Nat. \_\_\_\_\_

1st 24 hrs. after shot \_\_\_\_\_

Gas \_\_\_\_\_ Cu. Ft.

Dry Hole \_\_\_\_\_

Abandoned \_\_\_\_\_

Date

MAR 17 1943 19

S. J. LEWIS Scout

Map No. KANSAS 33 Sec. 22 Twp. 25 R. 14W

Well No. 1 Kipp "F"

Skelly et al. Company

Contractor

C SL SW SE

SECTION PLAT

\_\_\_\_\_ Ft. from N. Line

330 Ft. from S. Line

\_\_\_\_\_ Ft. from E. Line

660 Ft. from W. Line


KIPP POOL

Location XXX

Rig up \_\_\_\_\_

Drilling and Remarks:

RECORD

Cased \_\_\_\_\_ in., \_\_\_\_\_ ft.

Sand \_\_\_\_\_

Gas \_\_\_\_\_

Oil \_\_\_\_\_

Total Depth \_\_\_\_\_

PRODUCTION

1st 24 hrs. Nat. \_\_\_\_\_

1st 24 hrs. after shot \_\_\_\_\_

Gas \_\_\_\_\_ Cu. Ft.

Dry Hole \_\_\_\_\_

Abandoned \_\_\_\_\_

Date

JAN 20 1943 19

S. J. LEWIS Scout