


Section 22 Township 25 Range 14 W

Well No. # 3 Kipp "F"

Company Skelly Oil

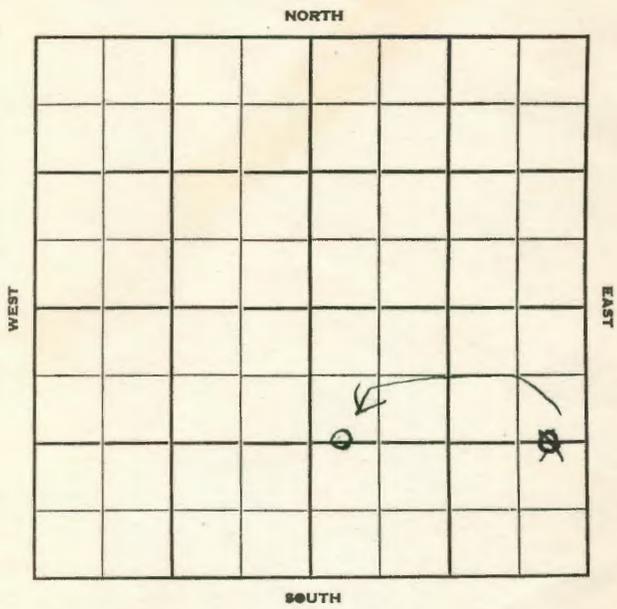

Sec. 22 Twp. 25 R. 14 W

Well No. #3 Kipp "F" Farm _____

Company Skelly Oil

Contractor _____

Kipp Pool


_____ Ft. from N. Line

1320 Ft. from S. Line

~~330~~ Ft. from E. Line

330 Ft. from W. Line

~~C E L E / 2 SE /~~
C W L W / 2 SE

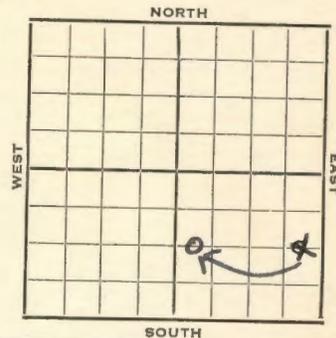

1952 Elev. 1977' REPORT

- 6/4 Location
- 6/11 Drlg. 3070'
- 6/18 Heeb 3522' Br li 3668' Lans. 3695'
Drlg. 3910'
- 6/25 KH 4052 Vi 4114
Simp sh 4238 Simp dol. 4244
Arb. 4276
f 4243-98 RTD Dol & shale schl.
5" @ 4278'
- 7/2 2 1/4 / 4243-49 4 gal OPH To hyd.
- 7/9 S/10 BO 8 hrs. 2000 A
- 7/17 S/1 1/2 BOPH PB 3951' 48/3911-23
1000 A S/221 BO plus 39 BW 14 hrs.
- 7/23 Spud 6-2-52 Oil Well TD 4298'
8" @ 864 Heeb. 3522 Br Li 3668
~~Simp dol. 4244~~ Lans. 3695 Kh 4052
Viola 4114 Simp. sh 4238
Simp. dol. 4244 Arb. 4276
5" @ 4278' TD 4298
2 1/4 / 4243-49 4 goph Hydro.
S/ 10 bo 8 hr. 2000 A S/ 1/2 boph
PB 3951 48/ 3911-23 1000 A
S/ 221 bo 39 bw 14 hr.
P. 13 bo 2 bw 13 hr.
Comp. 190 bopd 50 bw

COMPLETED

OVER

1953
7/22

O.W.W.O.

Oil well TD 4298'
KC 3695 **Simp. 4244** **Arb. 4276**
OTD 4298 5" @ 4279 Sq. perf
3911-23 CO to 4267
sd-Oil-frac 4243-49 P/13 BOPD
13 BW. Comp.

FIRST REPORT

✓

COMPLETED

Map No. _____ Sec. 22 Twp. 25 R. 14W


Well No. 3 Kipp "F"

Skelly Oil Company

CORRECTION Contractor

C W L W $\frac{1}{2}$ SE

SECTION PLAT

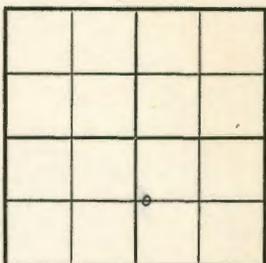

Ft. from N. Line

1320 Ft. from S. Line

Ft. from E. Line

330 Ft. from W. Line

Stafford County

Location _____

Rig up _____

Drilling and Remarks:

Reported
C E L E $\frac{1}{2}$ SE

JUN 11 1952

RECORD

Cased _____ in., _____ ft.

Sand _____

Gas _____

Oil _____

Total Depth _____

PRODUCTION

1st 24 hrs. Nat. _____

1st 24 hrs. after shot _____

Gas _____ Cu. Ft.

Dry Hole _____

Abandoned _____

Date

JUN 11 1952

19

J. G. McGEHEE Scout


County Stafford State Kansas

Sec. 22 (Bk. Twp.) 25 (Sur. Rge.) 14W Map No.

Operator Skelly Oil

Well No. 3 Farm Kipp "F"

Elev. 1977 Location C W L W $\frac{1}{2}$ SE

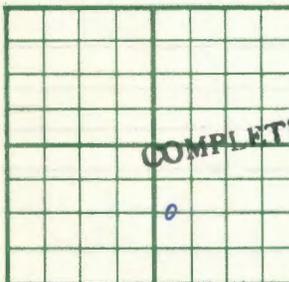

1320 Ft. From S Line SE

330 Ft. From W Line Quarter

1st. Report _____

Completion JUL 23 1952

Remarks Kipp Pool

Spudding Date 6-2-52

Drig. Data Oil well TD 4298

8" @ 864 Heeb. 3522 Br. lime 3668

Lans. 3695 Kh. 4052 Viola 4114

Simp. sh. 4238 Simp. dol. 4244

Arb. 4276 5" @ 4278 TD 4298

24/ 4243-49 4 goph Hydro. S/ 10 bo

8 hr. 2000 A S/ $\frac{1}{2}$ boph PB 3951

48/ 3911-23 1000 A S/ 221 bo 39 bw

14 hr. P/ 13 bo 2 bw 13 hr.

Comp. 190 bopd 50 bw

J. G. McGEHEE