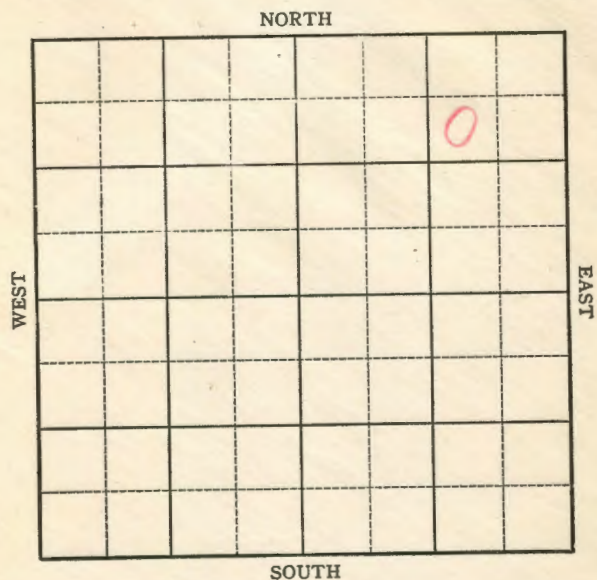


KANSAS

FORM 51 5M 6-46 PETROL

Stafford County

Section 23 Township 25 Range 14WWell No. #2 Kipp "A"Company Cities Service

5M 6-46 PETROL

KANSAS

Stafford County

Sec. 23 Twp. 25 R. 14WWell No. #2 Kipp "A" Farm _____

Cities Services _____ Company _____


Kipp

990 _____ Ft. from N. Line

_____ Ft. from S. Line

990 _____ Ft. from E. Line

_____ Ft. from W. Line

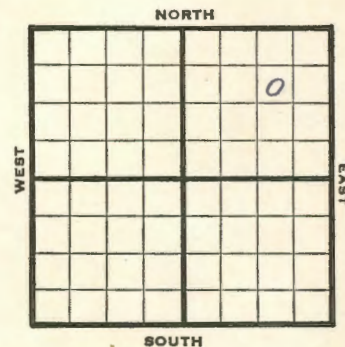

SW NE NE

1946 1974 REPORT

7/10 Location

7/16 8" @ 831
Drlg 2330'

7/23 **Lans 3674**
TD 3975
5" @ 3975 RUST

2/30 36 shots 3883-96
1000 acid

8/6 Swb 180 oil plus 2 4 W in
24 hrs. sqz.

8/13 45 shots 3842-52
12 gals oil PH

8/20 3500 acids swb 213 oil
plus 14 W in 24 hrs.

8/27 48 shots 2859-67
1000 acid
swb 75 oil plus 75 W in 20 hrs

9/8 **Lans 3674'**
5" @ 3975'
Perf Lans
1000 acid
Pump 144 Pot
39 Grav
TD 3975'

COMPLETED

Pool Name KippMap No. 83 Sec. 23 Twp. 25 R. 14WWell No. 2 Kipp "A"

Cities Service Company

COMPLETED

Contractor

SW NE NE

E1, 1974
SECTION PLAT990 Ft. from N. Line

Ft. from S. Line

990 Ft. from E. Line

Ft. from W. Line

Stafford County

Location

Rig up

Drilling and Remarks:

Lane 3674
3"-C 3975
Prof Lane
10000000
Pump 144 P.D.
8928

RECORD

Cased in. ft.Sand ft.Gas ft.Oil ft.Total Depth 8925

PRODUCTION

1st 24 hrs. Nat. ft.1st 24 hrs. after shot ft.Gas ft. Cu. Ft.Dry Hole ft.Abandoned ft.

Date

SEP 5 1946 19

S. J. LEWIS Scout

KANSAS

Kansas Pool Name KippMap No. 83 Sec. 23 Twp. 25 R. 14WWell No. 2 Kipp "A"

Cities Service Company

FIRST REPORT

Contractor

SW NE NE

SECTION PLAT

990 Ft. from N. Line

Ft. from S. Line

990 Ft. from E. Line

Ft. from W. Line

Stafford County

Location X

Rig up

Drilling and Remarks:

RECORD

Cased in. ft.Sand ft.Gas ft.Oil ft.Total Depth ft.

PRODUCTION

1st 24 hrs. Nat. ft.1st 24 hrs. after shot ft.Gas ft. Cu. Ft.Dry Hole ft.Abandoned ft.

Date

JUL 10 1946 19

S. J. LEWIS Scout