


Section 23 Township 25 Range 14-W

Well No. #1 E.J. Kipp

Company. Skelly Oil at al

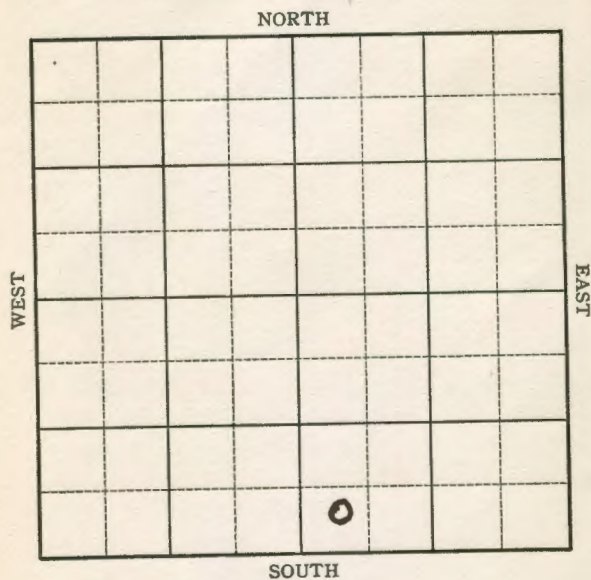

Sec. 23 Twp. 25 R. 14W

Well No. 1-E.J. Kipp Farm

Skelly Oil etal Company


_____ Ft. from N. Line

440 Ft. from S. Line

_____Ft. from E. Line

440 Ft. from W. Line

Elev. 1979

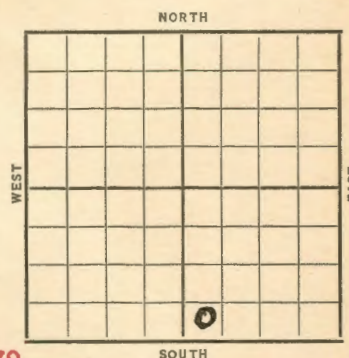[illegible]

KANSAS

Map No. 83 Sec. 23 Twp. 25 R. 14 W.

Well No. 1 - E. J. Kipp

Skelly Oil et al. Company

Contractor

ABANDONED

SECTION PLAT

		0	

Ft. from N. Line

440 Ft. from S. Line

440 Ft. from E. Line

Ft. from W. Line

Location

Rig up

Drilling and Remarks:

No Shows

D & A

RECORD

Cased in. ft.

Sand KC 3750

Gas

Oil

Total Depth 3811

PRODUCTION

1st 24 hrs. Nat.

1st 24 hrs. after shot

Gas Cu. Ft.

Dry Hole

Abandoned

Date

SEP 15 1937 19

H. D. Hatfield Scout

KANSAS

Map No. 83 Sec. 23 Twp. 25 R. 14 W.

Well No. 1 - E. J. Kipp

Skelly Oil et al. Company

Contractor

FIRST REPORT

SECTION PLAT

		0	

Ft. from N. Line

440 Ft. from S. Line

Ft. from E. Line

440 Ft. from W. Line

Location ✓

Rig up

Drilling and Remarks:

RECORD

Cased in. ft.

Sand

Gas

Oil

Total Depth

PRODUCTION

1st 24 hrs. Nat.

1st 24 hrs. after shot

Gas Cu. Ft.

Dry Hole

Abandoned

Date

AUG 11 1937 19

H. D. Hatfield Scout