


Stafford

KANSAS
14W

SECTION 23 TOWNSHIP 25 RANGE

WELL NO. #3 Tamer

COMPANY Crescent Corp

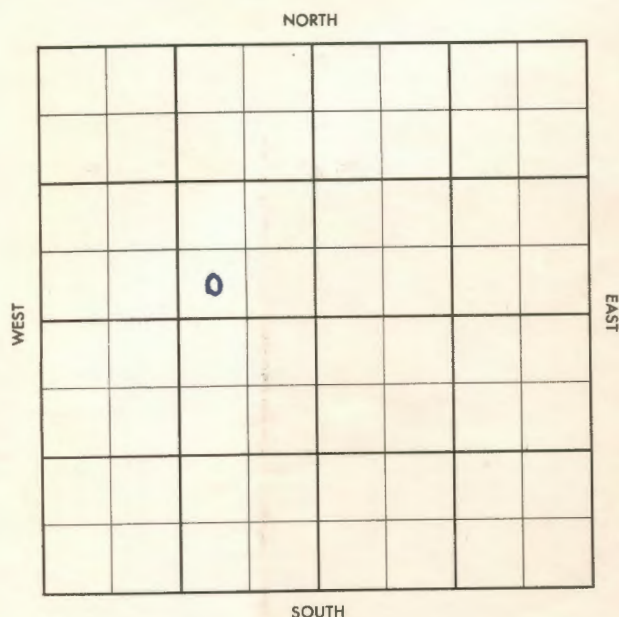

Stafford

KANSAS

SEC. 23 TWP. 25 R. 14W

WELL NO. #3 Tanner

COMPANY FARM

Crescent Corp.

CONTRACTOR

Gabbert-Jones

N. Kipp


Ft. from N. Line

Ft. from S. Line

Ft. from E. Line

Ft. from W. Line

SW SE NW

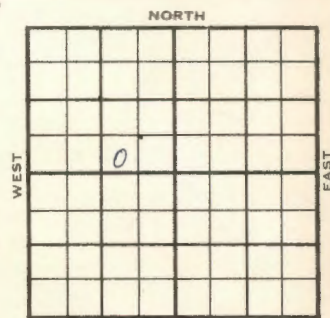

Phillips - FO

1956

ELEVATION

1971'

REPORT

4-25

Comm. 4-20-56
10" @ 318 w/300
Drlg. 2319

6-6

DST 3730-45 op 1 hr. gas in 50 min.
rec. 40' GCM, 1300/20".

DST 3784-94 op 1 hr. rec. 60' SOCMW
BHP 1000/20".

DST 3840-57 op 1 hr. gas in 12 min.
rec. 2040' clean oil, FP 140-390#.
1100/20".

DST 3877-86 op 1 hr. rec. 28' WCM
Press p/20"

RTD 4000'

Ran Log.

5 1/2" @ 3996

Co 3930, 36/3843-52

S/ 10 BOPD, no/wtr., 8 hrs.,

FU 2000' oil, 7 hrs., nat.

Grav. 33.

D/ 70 BOPD, no/wtr.,

IPP 91 BOPD, no/wtr.,

Grav. 34.

H. 3534', BL. 3682', L. 3712',

Log tops: H. 3532', Tr. 3550', Dg. 356

BL. 3680', L. 3710'.

TD 4000'

DX-78

COMPLETED

513 SUNRAY

County Stafford Elev. _____
 Sec. 23 Twp. 25 Rgs. 14W
 Company Crescent Corp.
 Farm Name Tanner No. 3

TOPS	DEPTH	LOG	DATUM	Loc. in Sec.
Anh.				SW SE NW
Tr.				
H.				
Tr.				
Dg.				
Bl.				
L.				Geol. _____
N.C.				Contr. _____
B.K.C.				Gabbert-Jones
Ce.				
C.				Pool
M.				N. Kipp
M.				
K.				
Mr.				
Me.				
V.				
S.				
S.				
A.				
R.				
Pe.				
G.				
TD.				

FIRST REPORT

APR 25 1956

Date Comm. 4-20-56 Phillips FO

10" @ 318/300 d-lg. 2319

3201 C YAM

C. R.

County Stafford Elev. 1971
 Sec. 23 Twp. 25 Rge. 11W
 Company Crescent Corp.
 Farm Name Tanner No. 3

TOPS	DEPTH	LOG	DATUM	Loc. in Sec.
Anh.				SW SE NW
Tr.				
H.	3534	3532		
Tr.		3550		
Dg.		3568		
Bl.	3682	3680		
L.	3712	3710		
K.C.				Geol.
B.K.C.				Contr.
Ce.				Gabbert-Jones
C.				
M.				Pool
M.				N. Kipp
K.				
Mz.				
Me.				
V.				
S.				
S.				
A.				
R.				
Pe.				
G.				
TD	4000	3995		COMPLETE

Date Comm. 4-20-56 Phillips FO

10" @ 318/300 drlg. 2319 MAY 2 '56

DST 3730-45 1hr 9 in 50" TSTM
 rec 40' GCM 1300/20 DST
 3784-94 1hr 60' 50CMW BHP
 1000/20" DST 3840-57 1hr 900
 in 12" rec 2040' clean oil
 FP 140-390 1100/20" DST 3877
 -P6 1hr rec 28' WCM press 2/24
 D 3890 MAY 9 '56 RTD 4000 Ran

23-25-14W

Log 5 1/2 @ 3996 MICT CO 3930
 36/ 3843-52 no tst nat/Van #
 10 Boph no/w 8 hrs Log Tops
 MAY 16 '56 EU 2000' oil 7 hrs nat
 gran 33° POP. MAY 23 '56 P. 70
 Bopd no/wtr wo st tst. MAY 29 '56
 X wo st tst. JUN 6 '56
 1PP 91 BOPD NW 34°
 Log pts 3843-52