


Section 22 Township 25 Range 14-W

Well No. #2 Kipp "F"

Company Skelly

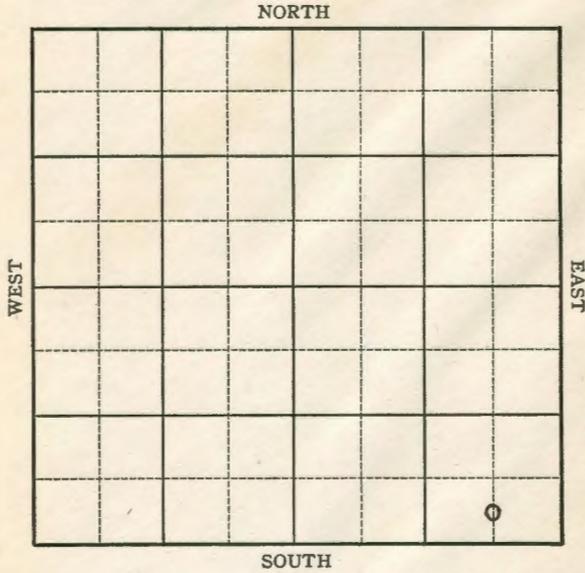

Sec. 22 Twp. 25 R. 14-W

Well No. #2 Kipp "F" Farm _____

Skelly Company _____


Kipp

_____ Ft. from N. Line

330 Ft. from S. Line

660 Ft. from E. Line

660 Ft. from W. Line

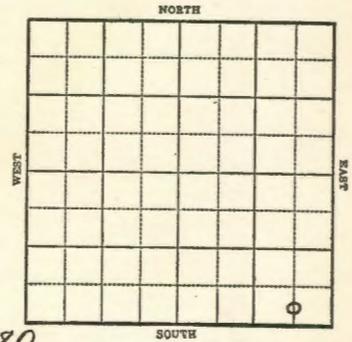

elec. 1980

1943

REPORT

- 4/28 Derrick
- 5/5 10" @ 397' WOC.
- 5/12 Drlg. 2655'
- 5/19 **Lans 3698**
Drlg. 3847
- 5/26 T.D. 3847
6" @ 3847-3/4 oil in 3 hrs.
- 6/2 **Lans 3698**
6" @ 3845
T.D. 3901'
500 gal acid
Pump 308 Pot
Gravity 34.1

COMPLETED

Map No. 23 Sec. 22 Twp. 25 R. 14W

Well No. 2 Kipp "F"

Skelly Company

COMPLETED Contractor

C SL SE SE

SECTION PLAT

 Ft. from N. Line

330 Ft. from S. Line

660 Ft. from E. Line

 Ft. from W. Line

KIPP POOL

Location

Rig up

Drilling and Remarks:

*Lane 8695
6" C3845
500 acid
Pump 808 RT
34' Se*

RECORD

Cased in., ft.

Sand

Gas

Oil

Total Depth 370'

PRODUCTION

1st 24 hrs. Nat.

1st 24 hrs. after shot

Gas Cu. Ft.

Dry Hole

Abandoned

Date

JUN 2 1943 19

S. J. LEWIS Scout

Map No. 23 Sec. 22 Twp. 25 R. 14W

Well No. 2 Kipp "F"

Skelly Company

FIRST REPORT Contractor

C SL SE SE

SECTION PLAT

 Ft. from N. Line

330 Ft. from S. Line

660 Ft. from E. Line

 Ft. from W. Line

KIPP POOL

Location

Rig up

Drilling and Remarks:

Derrick

RECORD

Cased in., ft.

Sand

Gas

Oil

Total Depth

PRODUCTION

1st 24 hrs. Nat.

1st 24 hrs. after shot

Gas Cu. Ft.

Dry Hole

Abandoned

Date

APR 2 8 1943 19

S. J. LEWIS Scout