


SECTION 23 TOWNSHIP 25 RANGE 14W

WELL NO. #1 Kipp

COMPANY Phillips Petr.

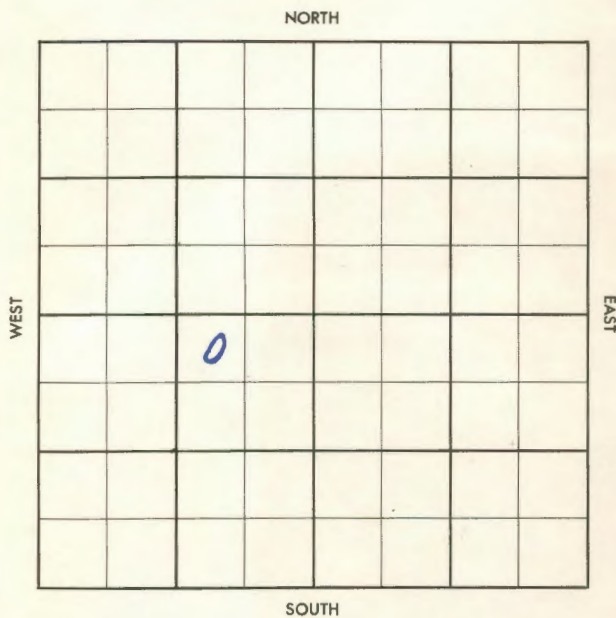

SEC. 23 TWP. 25 R. 14W

WELL NO. #1 Kipp

COMPANY Phillips Petr.

CONTRACTOR Co. Tools

Kipp


Ft. from N. Line

Ft. from S. Line

Ft. from E. Line

Ft. from W. Line

NW NE SW

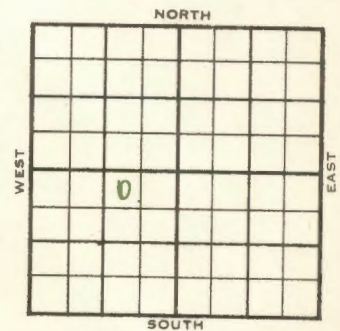

1956 ELEVATION 1972 DF REPORT

5-9 Comm. 5-3-56
9" @ 386 /w/143
Dr1g. 2251

5-23 DST 3854-71 op 1 hr. rec. 20' WM, FP 10-15, BHP 205/20"
DST 3894-3900 op 1 hr. rec. 6' wm, nosl
FP 15-15, BHP 15/20"
RTD 4032, Ran log.

D&A

H.	3543	3544
Tr.	3561	3553
Dg.	3581	3582
BL.	3694	3696
L.	3724	3727
KC	3861	3862
BKC		4020

TD 4033'

ABANDONED

County Stafford Elev. 1972 DF
 Sec. 23 Twp. 25 Rge. 14W
 Company Phillips Pet.
 FarmName Kipp No. 1

TOPS	DEPTH	LOG	DATUM	Loc. in Sec.
Anb.				NW NE SW
Tr.				
H.				
Tr.				
Dg.				Co. tools
BL.				
L.				
K.C.				
B.K.C.				Kipp
Ce.				
C.				
M.				
M.				FIRST REPORT
K.				
Mz.				
Me.				
V.				MAY 9 '56
S.				
A.				
R.				
PE.				No.
G.				

Date Comm. 5-3-56
9" @ 386/143 drlg. 2251

2251 4 I TAM

D.R.

County Stafford Elev. 1972 DF
 Sec. 23 Twp. 25 Rge. 14W
 Company Phillips Pet.
 FarmName Kipp No. 1

TOPS	DEPTH	LOG	DATUM	Loc. in Sec.
Anb.				NW NE SW
Tr.				
H.				
Tr.				
Dg.				Co. tools
BL.				
L.				
K.C.				
B.K.C.				Kipp
Ce.				
C.				
M.				
M.				ABANDONED
K.				
Mz.				
Me.				
V.				No.
S.				
A.				
R.				
PE.				Sec.
G.				

Date Comm. 5-3-56 MAY 23 1956
9" @ 386/143 drlg. 2251 MAY 16 '56 Hb

3543 Tr 3561 Dg 3581 BL 3694 Kc
3861 DST 3854-71 1hr rec 20' WM
FP 10-15 BHP 205/20" DST 3894
-3906 1hr rec 6' WM no sh.
FP 15-15 BHP 15/20" ahead
MAY 23 '56 X RTD 4032 Ran Log

D&A Rig to Harvey