


KANSAS Stafford county

Section 23 Township 25 Range 14W

Well No. #1, Kipp

Company Cities Service

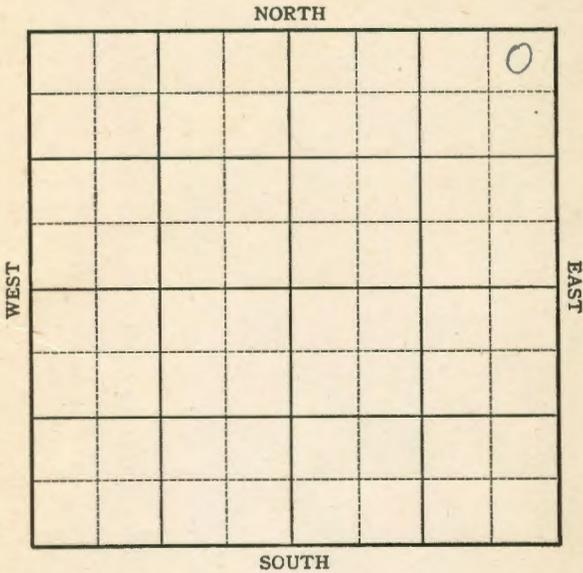

KANSAS Stafford County

Sec. 23 Twp. 25 R. 14W

Well No. #1 Kipp Farm _____


Cities Service Company _____

Wildcat
330 Ft. from N. Line

_____ Ft. from S. Line

380 Ft. from E. Line

_____ Ft. from W. Line

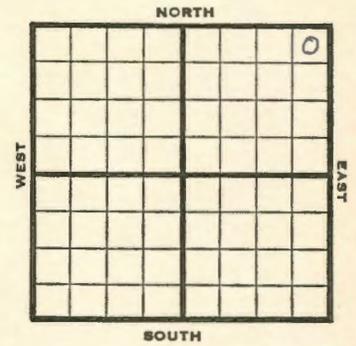

NE/c

1946 **Elev. 1968** REPORT

- 4/10 RUR
- 4/16 10" @ 395 Drlg 2400
- 4/23 **Lans 3659**
Sat 3869 TD
- 5/1 **Viola 4145**
Drlg 4205'
- 5/7 **Simp sd 4217**
Arb 4257
TD 4303
5" @ 3973-36 shots 3852-63
46 shots 3844-61
HFO in 8 hrs
- 5/14 2000 acid flow 100 oil in 24 hrs
- 5/22 **Lans 3659**
Arb. 4257
5" @ 3973
Perf. Lans.
TD 4303'
Bomb Pot. 1260 oil No. W.
Grav. 32.2

COMPLETED

83 KANSAS Kansas Pool Name Kipp NE
Map No. 83 Sec. 23 Twp. 25 R. 14W

Well No. 1 Kipp
Cities Service Company

COMPLETED Contractor

NE/C SECTION PLAT E 11 1945

<u>330</u> Ft. from N. Line				
_____ Ft. from S. Line				
<u>330</u> Ft. from E. Line				
_____ Ft. from W. Line				

Stafford County

Location _____

Rig up _____

Drilling and Remarks:

*None 3659
C 2 4257
5 203978
Perf. done.
Borehole 2 1/2 60 oil
do H.
32 2 94*

RECORD
Cased _____ in., _____ ft.
Sand _____
Gas _____
Oil _____
Total Depth 4302

PRODUCTION
1st 24 hrs. Nat. _____
1st 24 hrs. after shot _____
Gas _____ Cu. Ft.
Dry Hole _____
Abandoned _____

Date MAY 22 1946 19 S. J. LEWIS Scout

KANSAS Kansas Pool Name Wildcat
Map No. 83 Sec. 23 Twp. 25 R. 14W

Well No. 1 Kipp
Cities Service Company

FIRST REPORT Contractor

NE/C SECTION PLAT

<u>330</u> Ft. from N. Line				
_____ Ft. from S. Line				
<u>380</u> Ft. from E. Line				
_____ Ft. from W. Line				

Stafford County

Location _____

Rig up _____

Drilling and Remarks:

R U R

RECORD
Cased _____ in., _____ ft.
Sand _____
Gas _____
Oil _____
Total Depth _____

PRODUCTION
1st 24 hrs. Nat. _____
1st 24 hrs. after shot _____
Gas _____ Cu. Ft.
Dry Hole _____
Abandoned _____

Date APR 10 1946 19 S. J. LEWIS Scout