

KANSAS


Stafford County

FORM 51 5M 11-44 PETROL

Section 24 Township 25 Range 14W

Well No. #1 Kippe "B"

Company Cities Service

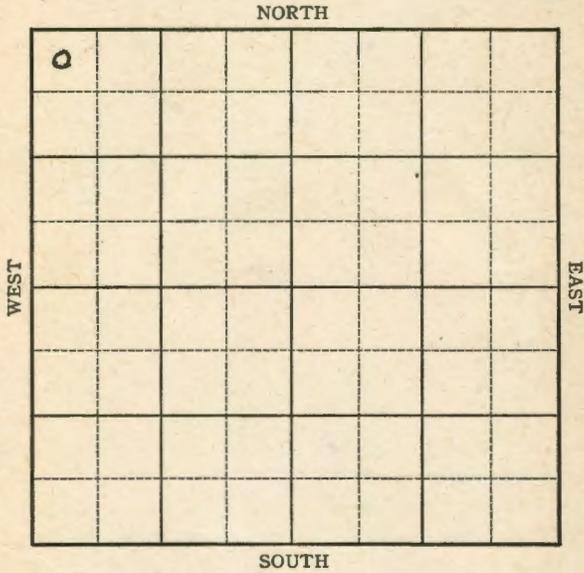

5M 8-45 PETROL

KANSAS

Stafford county

Sec. 24 Twp. 25 R. 14W

Well No. #1, Kippe "B" Farm \_\_\_\_\_

Company Cities Service


Kipp

330 Ft. from N. Line

\_\_\_\_\_ Ft. from S. Line

\_\_\_\_\_ Ft. from E. Line

330 Ft. from W. Line

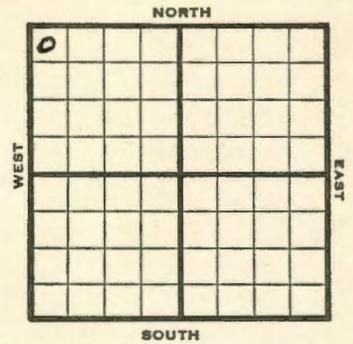

NW / C

1946 **Elev. 1970** REPORT

- 6/12 RUR
- 6/18 8" @ 845  
Drlg 2800'
- 6/26 **Lans 3700**  
TD 3996 SO  
5" @ 3996 RUST
- 7/3 95 shots 3852-73  
Swb & flow 160 oil in 24 hrs.
- 7/9 2000 acid  
Bomb test 2775 oil
- 7/16 " "
- 7/24 **Lans 3670**  
5" @ 3996  
Perf. Lans.  
2000 acid.  
TD 3996  
Bomb Pot. 3253  
Max. 3000  
Grav. 32.4

**COMPLETED**

KANSAS

Kansas Pool Name Kipp Pool

Map No. 83 Sec. 24 Twp. 25 R. 14W

Well No. 1 Kipp "B"

Cities Service Company

COMPLETED

Contractor

NW/C

E 11970  
SECTION PLAT

330 Ft. from N. Line

\_\_\_\_\_ Ft. from S. Line

\_\_\_\_\_ Ft. from E. Line

330 Ft. from W. Line

0			

Stafford County

Location \_\_\_\_\_

Rig up \_\_\_\_\_

Drilling and Remarks:

*Lans 3670*  
*5" C 3996*  
*Prof. Lam.*  
*2000 cu ft*  
*Barrel 3203*  
*May 3000*  
*32 1/2 ft*

RECORD

Cased \_\_\_\_\_ in, \_\_\_\_\_ ft.

Sand \_\_\_\_\_

Gas \_\_\_\_\_

Oil \_\_\_\_\_

Total Depth 3776

PRODUCTION

1st 24 hrs. Nat. \_\_\_\_\_

1st 24 hrs. after shot \_\_\_\_\_

Gas \_\_\_\_\_ Cu. Ft.

Dry Hole \_\_\_\_\_

Abandoned \_\_\_\_\_

Date

JUL 24 1946 19

S. J. LEWIS Scout

KANSAS

Kansas Pool Name Kipp

Map No. 83 Sec. 24 Twp. 25 R. 14W

Well No. 1 Kippe "B"

Cities Service Company

FIRST REPORT

Contractor

NW/C

SECTION PLAT

330 Ft. from N. Line

\_\_\_\_\_ Ft. from S. Line

\_\_\_\_\_ Ft. from E. Line

330 Ft. from W. Line

9			

Stafford County

Location \_\_\_\_\_

Rig up \_\_\_\_\_

Drilling and Remarks:

RUR

RECORD

Cased \_\_\_\_\_ in, \_\_\_\_\_ ft.

Sand \_\_\_\_\_

Gas \_\_\_\_\_

Oil \_\_\_\_\_

Total Depth \_\_\_\_\_

PRODUCTION

1st 24 hrs. Nat. \_\_\_\_\_

1st 24 hrs. after shot \_\_\_\_\_

Gas \_\_\_\_\_ Cu. Ft.

Dry Hole \_\_\_\_\_

Abandoned \_\_\_\_\_

Date

JUN 12 1946 19

S. J. LEWIS Scout