


Section 23 Township 25 Range 14W

Well No. 2 Tanner

Company Deep Rock

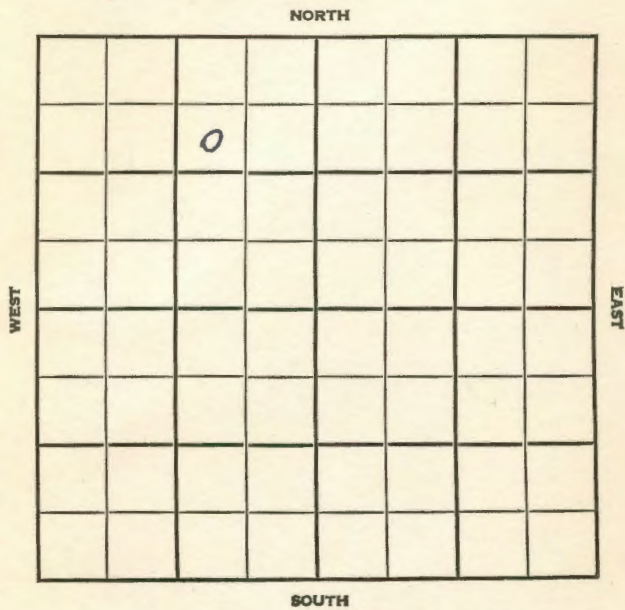

SEC.	TWP.	R.
23	25	14W

WELL NO. #2 Tanner FARM

COMPANY Deep Rock


CONTRACTOR Gabbert-Jones

N. Kipp Pool
990 Ft. from N. Line

Ft. from S. Line

990 Ft. from E. Line

Ft. from W. Line

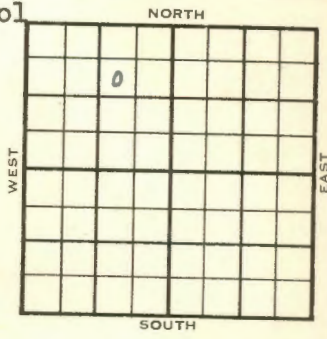

SW NE NW
Phillips F/0

1954	ELEVATION 1973'	REPORT
------	--------------------	--------

11/3 Location
 11/23 Spud 11-3-54 - D&A
 TD 3910'
 10-3/4" @ 308'
 Heeb 3546', Tor 3566', B. Oread 3584'
 Br line 3699', Lans 3728'
 DST 3859-73', opn lhr., rec. 30' mud
 off
 TD 3910'
 D&A

ABANDONED

