


Section 24 Township 25 Range 14W

Well No. 1 Toland

Company A.D. Allison, et al
Wildcat

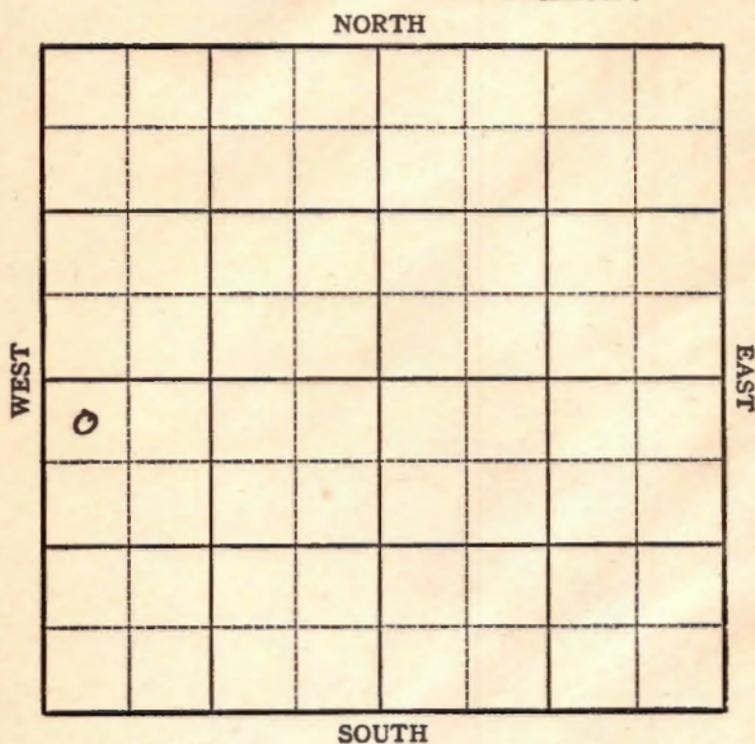

STAFFORD
~~Pratt~~

KANSAS

Sec. 24 Twp. 25 R. 14W ✓

Well No. #1 Toland Farm

A. D. Allison et al Company


Wildcat

330' Ft. from N. Line

_____ Ft. from S. Line

_____ Ft. from E. Line

330' Ft. from W. Line

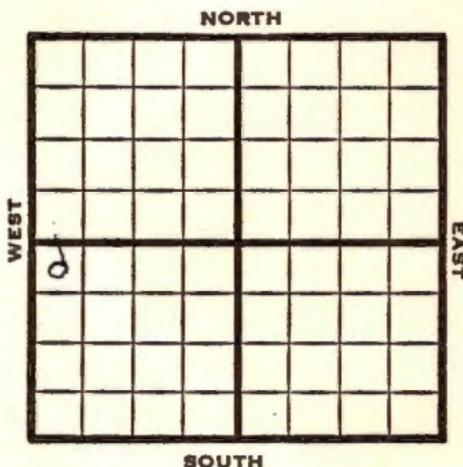

NW SW

1948

Elev. 1976' REPORT

10/27

RUR

11/3

8" @ 300'

Drlg 1430'

11/10

Drlg 3730'

11/17

Lans. 3728'

Miss 4167'

Kind 4182'

TD 4209'

ABANDONED

Map No. 83 Sec. 24 Twp. 25 R. 14W

Well No. 1 Toland

A. D. Allison et al. Company

ABANDONED

Contractor

NW SW

E11976.

SECTION PLAT

330 Ft. from N. Line

_____ Ft. from S. Line

_____ Ft. from E. Line

330 Ft. from W. Line

o			

Stafford County

Location _____

Rig up _____

Drilling and Remarks:

Lane 3725

Mis 4162

Kind 4182

RECORD

Cased _____ in., _____ ft.

Sand _____

Gas _____

Oil _____

Total Depth 4209

PRODUCTION

1st 24 hrs. Nat. _____

1st 24 hrs. after shot _____

Gas _____ Cu. Ft.

Dry Hole _____

Abandoned _____

Date

NOV 17 1948 19

S. J. LEWIS

Scout

Map No. 83 Sec. 24 Twp. 25 R. 14W

Well No. 1 Toland

A. D. Allison et al. Company

CORRECTION Contractor

NW SW

SECTION PLAT

330 Ft. from N. Line

_____ Ft. from S. Line

_____ Ft. from E. Line

330 Ft. from W. Line

o			

Stafford County

Location _____

Rig up _____

Drilling and Remarks:

Reported in
Pratt County

RECORD

Cased _____ in., _____ ft.

Sand _____

Gas _____

Oil _____

Total Depth _____

PRODUCTION

1st 24 hrs. Nat. _____

1st 24 hrs. after shot _____

Gas _____ Cu. Ft.

Dry Hole _____

Abandoned _____

Date

OCT 27 1948

19

S. J. LEWIS

Scout

Map No. _____ Sec. 24 Twp. 25 R. 14W

Well No. 1 Toland

A. D. Allison et al. Company

FIRST REPORT Contractor

NW SW

SECTION PLAT

330 Ft. from N. Line

_____ Ft. from S. Line

_____ Ft. from E. Line

330 Ft. from W. Line

o			

Pratt County

Location _____

Rig up _____

Drilling and Remarks:

R U R

RECORD

Cased _____ in., _____ ft.

Sand _____

Gas _____

Oil _____

Total Depth _____

PRODUCTION

1st 24 hrs. Nat. _____

1st 24 hrs. after shot _____

Gas _____ Cu. Ft.

Dry Hole _____

Abandoned _____

Date

OCT 27 1948

19

S. J. LEWIS Scout