


Section 25 Township 25 Range 14 W

Well No. # 1 Goodman

Company Dewis Drlg.

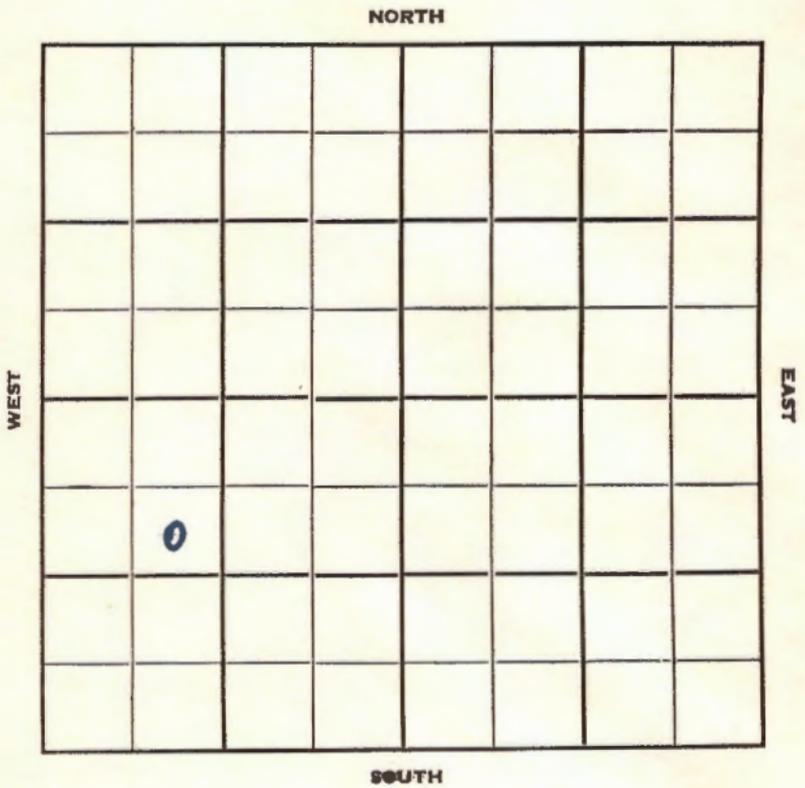

Sec. 25 Twp. 25 R. 14W

Well No. #1 Goodman Farm

Dewis Drlg. Company

Dewis Contractor

Wildcat


990 Ft. from N. Line

Ft. from S. Line

Ft. from E. Line

990 Ft. from W. Line

SE NW SW

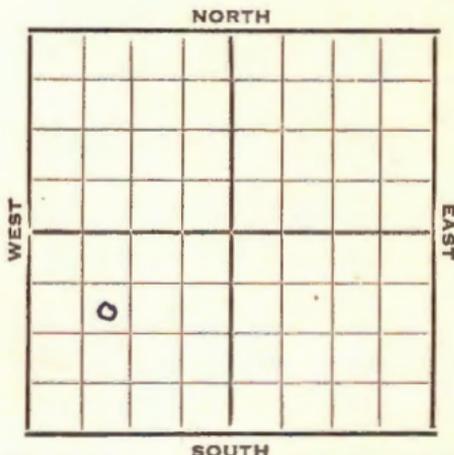

1952

Elev. 1981' REPORT

8/27 Spud 8-25-52  
8" @ 727' WOC

9/3 NR

9/10 Drlg. 4085

9/17 Spud 8-25-52  
D & A TD 4390'  
8" @ 727 Heeb 3591' Br. lime 3743'  
Lans. 3769' Simp. 4366'  
TD 4390' D & A

**ABANDONED**

L-3769  
1981  
1988


County **Stafford** State **Kansas**

Sec. **25** (Blk. Twp.) **25** (Sur. Rge.) **14W** Map No.

Operator **Dewis Drlg.**

Well No. **1** Farm **Goodman**

Elev. Location **SE NW SW**

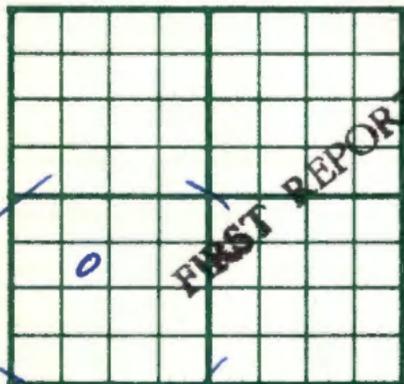

**990** Ft. From **N** Line **SW**

**990** Ft. From **W** Line Quarter

Ist. Report **AUG 27 1952**

Completion

Remarks

**Dewis - Contr.**

Spudding Date **8-25-52**

Drlg. Data **Wildcat**

**8" @ 727 WOC**

J. G. McGEHEE

County Stafford State Kansas

Sec. 25 (Blk.) 25 (Sur.) 14W Map No. (Twp.)

Operator Lewis Drlg.

Well No. 1 Farm Goodman

Elev. 1981 Location SE NW SW


990Ft. From N Line SW

990Ft. From W Line Quarter

1st. Report

Completion SEP 17 1952

Remarks Wildcat

Lewis Drlg. - Contr.

Spudding Date 8-25-52

Drlg. Data D & A TD 4390

8" @ 727 Heeb. 3591 Br. lime 3743

Lens. 3769 Simp. 4366 TD 4390

D & A