


KANSAS

Stafford

Section 26 Township 25 Range 14-W

Well No. 1 Kipp "C"


Company Skelly Oil

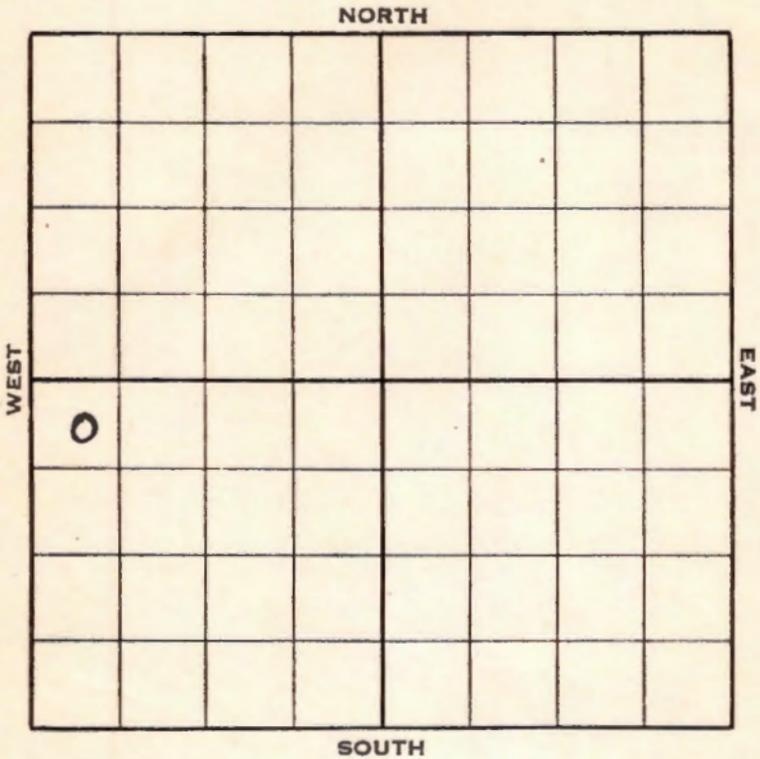

Sec. 26 Twp. 25 R. 14-W

Well No. #1 Kipp "C" Farm \_\_\_\_\_  
Skelly Oil Company \_\_\_\_\_

440 Ft. from N. Line  
 \_\_\_\_\_ Ft. from S. Line  
 \_\_\_\_\_ Ft. from E. Line  
440 Ft. from W. Line

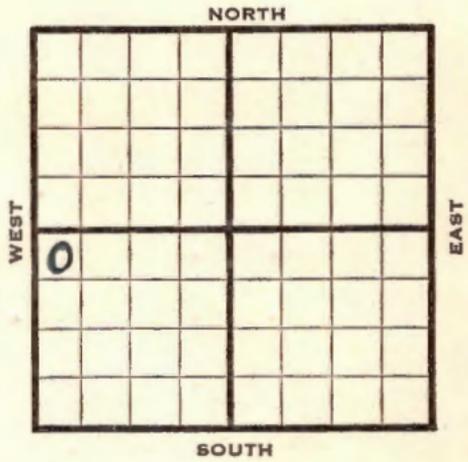

**Elev/ 1991**

1938	REPORT
4/13	Location
4/22	B.R.R.
4/29	Reaming 900'.
5/6	Anhy 860'. 10" @ 883'. Drlg. 2290'.
5/12	Drlg. 3210'.
5/20	Lans. 3708'. T.D. 3857'. S.O. & G. 7" at 3845'. RUST.
5/27	Drilled plug. 400' oil in 5 hrs. Cleaning out.
6/3	T.D. 3912'. Swab 114 bbls. oil in 11 hours. 38,780 gas. Perf. 100 shots. 3732-49'.

**OVER**

1938

6/8

7" @ 3845'.

K. C. 3846'.

T. D. 3912'.

Perf. 3732-49.

7000 acid.

Potential 1589 bbls.

Gravity 33.8 - 70

COMPLETED

Map No. 83 Sec. 26 Twp. 25 R. 14W

Well No. 1 Kipp "C"

Skelly Oil

Company

Contractor

FIRST REPORT

SECTION PLAT

NW SW

440 Ft. from N. Line

\_\_\_\_\_ Ft. from S. Line

\_\_\_\_\_ Ft. from E. Line

440 Ft. from W. Line

0			

Location X

Rig up \_\_\_\_\_

Drilling and Remarks:

RECORD

Cased \_\_\_\_\_ in., \_\_\_\_\_ ft.

Sand \_\_\_\_\_

Gas \_\_\_\_\_

Oil \_\_\_\_\_

Total Depth \_\_\_\_\_

PRODUCTION

1st 24 hrs. Nat. \_\_\_\_\_

1st 24 hrs. after shot \_\_\_\_\_

Gas \_\_\_\_\_ Cu. Ft.

Dry Hole \_\_\_\_\_

Abandoned \_\_\_\_\_

Date

APR 13 1938

19

H. D. Hatfield Scout

Map No. 83 Sec. 26 Twp. 25 R. 14W

Well No. 1 Kipp "C"

Skelly Oil Company

Contractor

**COMPLETED**

NW SW

440 Ft. from N. Line

\_\_\_\_\_ Ft. from S. Line

\_\_\_\_\_ Ft. from E. Line

440 Ft. from W. Line

**SECTION PLAT**

0			

Location \_\_\_\_\_

Rig up \_\_\_\_\_

Drilling and Remarks:

*Perf. 3132-49*

*7000 Acid*

*POT 1589*

*grav 33.8/70*

**RECORD**

Cased 7 in., 3845 ft.

Sand KC 3846

Gas \_\_\_\_\_

Oil \_\_\_\_\_

Total Depth 3912

**PRODUCTION**

1st 24 hrs. Nat. \_\_\_\_\_

1st 24 hrs. after shot \_\_\_\_\_

Gas \_\_\_\_\_ Cu. Ft.

Dry Hole \_\_\_\_\_

Abandoned \_\_\_\_\_

Date

**JUN 8 - 1938** 19

**H. D. Hatfield** Scout