

KANSAS

Stafford

FORM 51 5M PETROL

Section 26 Township 25 Range 14W

Well No. #2 Kipp "C"


Company Skelly

Kipp Pool

NORTH

WEST

EAST

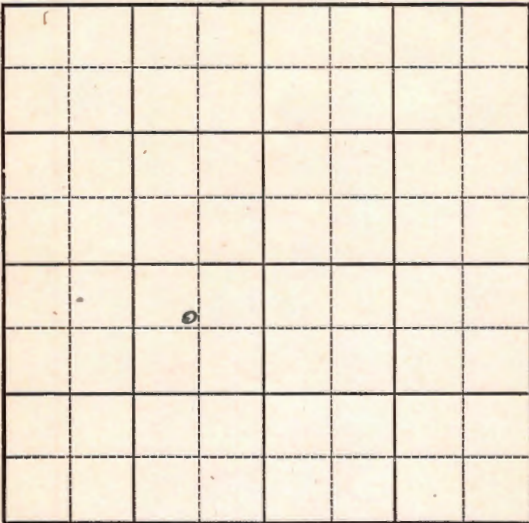

SOUTH

KANSAS

Stafford

Sec. 26 Twp. 25 R. 14-W

Well No. #2, Kipp "C" Farm

Skelly Company

554

Ft. from N. Line


Ft. from S. Line

Ft. from E. Line

766

Ft. from W. Line

Elev. 1981

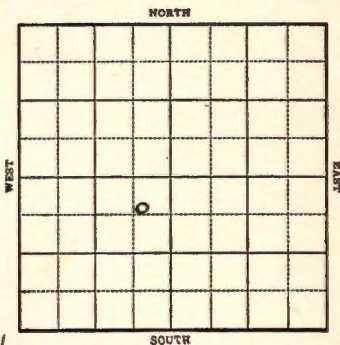

R E P O R T

1943
12/15

Location

12/22

"

12/29

"

1944

1-5

"

1-12

"

1/19

Rotary

1/26

Drlg. 415'

2/2

8" @ 415
Drlg. 2410'

2/8

Lans 3725

TD 2932

No shows

SD

2/16

Lans 3725

T 3932

No shows.

ABANDONED

KANSASMap No. 83 Sec. 26 Twp. 25 R. 14WWell No. 2 Kipp "C"Skelly CompanyABANDONED Contractor**C NE SW****SECTION PLAT**

	o		

554 Ft. from N. Line Ft. from S. Line Ft. from E. Line766 Ft. from W. Line**Kipp Pool**Location Rig up

Drilling and Remarks:

*Ham 8725**Noshovz***RECORD**Cased in., ft.Sand Gas Oil Total Depth 8982**PRODUCTION**1st 24 hrs. Nat. 1st 24 hrs. after shot Gas Cu. Ft.Dry Hole Abandoned

Date

FEB 16 194419S. J. LEWISScout

KANSAS

Map No. 83 Sec. 26 Twp. 25 R. 14WWell No. 2 Kipp "C"Skelly CompanyFIRST REPORT Contractor

C NE SW

SECTION PLAT

	o		

554 Ft. from N. Line Ft. from S. Line Ft. from E. Line766 Ft. from W. LineKipp PoolLocation XRig up

Drilling and Remarks:

RECORD

Cased in., ft.Sand Gas Oil Total Depth

PRODUCTION

1st 24 hrs. Nat. 1st 24 hrs. after shot Gas Cu. Ft.Dry Hole Abandoned

Date

DEC 15 1943 19S. J. LEWIS Scout