

KANSAS

Stafford

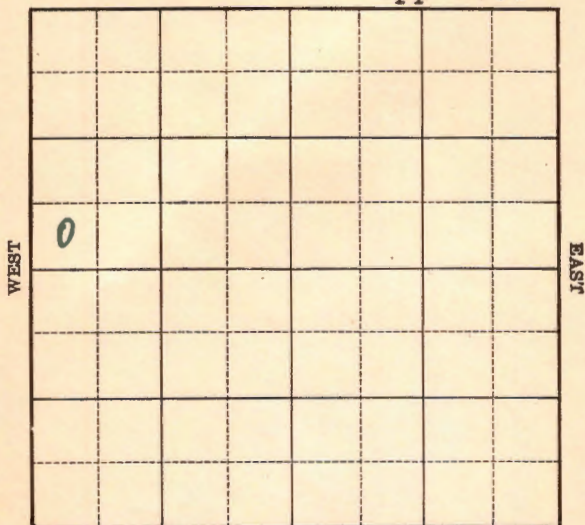
Form 51—5M—7-39—Palace

Section 26 Township 25 Range 14-W

Well No. #1 Kipp "E"

Company Skelly et al

NORTH Kipp Pool



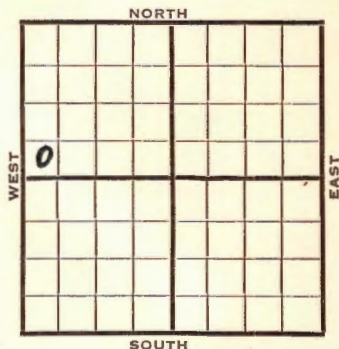
SOUTH

**KANSAS**

Stafford

Sec. 26 Twp. 25 R. 14-WWell No. #1 Kipp "E" FarmSkelly et al Company

(Kipp)

       Ft. from N. Line440 Ft. from S. Line       Ft. from E. Line440 Ft. from W. Line**Elev. 1982**

## REPORT

|      |                                 |
|------|---------------------------------|
| 1940 |                                 |
| 5/15 | Drlg. 500'                      |
| 5/23 | 10" - 404' Drlg. 2270'          |
| 5/29 | Drlg. 3700'                     |
| 6/6  | <b>Lansing 3694'</b> 5" - 3836' |
|      | Drlg. 3902' 2500' oil in hole.  |
| 6/13 | SD 3909'                        |
|      |                                 |
| 6/19 | <b>Lans. 3694'</b>              |
|      | 5" - 3836'                      |
|      | T.D. 3909'                      |
|      | 7000 acid.                      |
|      | Potential 568 bbls., pump.      |

**COMPLETED**

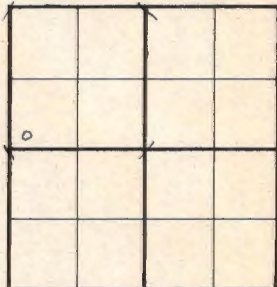
Map No. 83 Sec. 26 Twp. 25 R. 14WWell No. 1 Kipp "E"Skelly etal Company

Contractor

FIRST REPORT  
SW NW       Ft. from N. Line440 Ft. from S. Line       Ft. from E. Line440 Ft. from W. Line

Kipp Pool

## SECTION PLAT

Location                     Rig up                     

Drilling and Remarks:

Drlg. 500

## RECORD

Cased            in.,            ft.Sand                     Gas                     Oil                     Total Depth                     

## PRODUCTION

1st 24 hrs. Nat.                     1st 24 hrs. after shot                     Gas                      Cu. Ft.Dry Hole                     Abandoned                     

Date

MAY 15 1940 19S. J. LEWIS Scout

Map No. 83 Sec. 26 Twp. 25 R. 14WWell No. 1 Kipp "E"Skelly etal

Company

Contractor

COMPLETED

SW NW

Ft. from N. Line

440 Ft. from S. Line

Ft. from E. Line

440 Ft. from W. Line

## SECTION PLAT

|  |  |  |  |
|--|--|--|--|
|  |  |  |  |
|  |  |  |  |
|  |  |  |  |
|  |  |  |  |

KIPP POOL

Location \_\_\_\_\_

Rig up \_\_\_\_\_

Drilling and Remarks:

*Loss 3694**5" @ 3836**7000 acid**Pump 568 Pst*

## RECORD

Cased \_\_\_\_\_ in., \_\_\_\_\_ ft.

Sand \_\_\_\_\_

Gas \_\_\_\_\_

Oil \_\_\_\_\_

Total Depth 3909

## PRODUCTION

1st 24 hrs. Nat. \_\_\_\_\_

1st 24 hrs. after shot \_\_\_\_\_

Gas \_\_\_\_\_ Cu. Ft.

Dry Hole \_\_\_\_\_

Abandoned \_\_\_\_\_

Date

JUN 19 1940 19

S. J. LEWIS Scout