

Stafford


Section 26 Township 25 Range 14-W

Well No. #2 Kipp "E"

Company Skelly Oil et al

Kipp Pool

NORTH

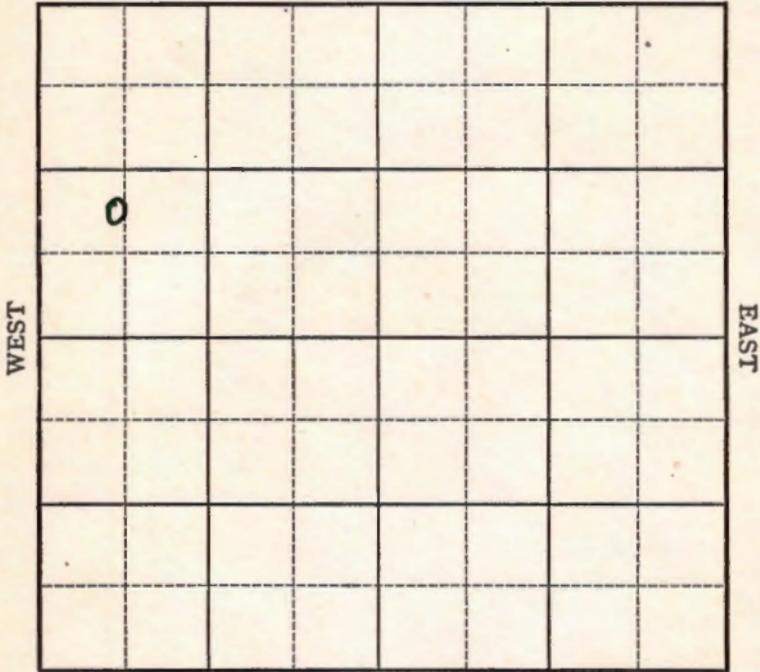

SOUTH

Sec. 26 Twp. 25 R. 14-W

Well No. #2 Kipp "E" Farm

Skelly Oil et al Company


(Kipp)

_____ Ft. from N. Line

993 Ft. from S. Line

_____ Ft. from E. Line

560 Ft. from W. Line

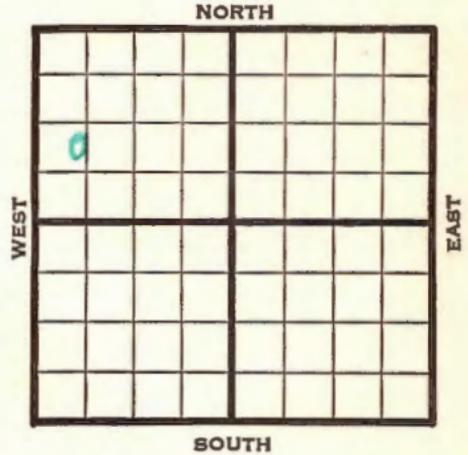

Elev. 1978

1941	REPORT
5/27	Derrick.
6/5	8" - 414' Drlg. 1876'
6/12	Drlg. 3460'
6/19	Lans. 3695' 5" - 3836'
	T.D. 3837' RUST.
6/26	T.D. 3891' 7000 acid.
7/1	Lans. 3695'
	5" - 3836'
	T.D. 3891'
	7000 acid.
	Bomb potential 4971 bbls.
	Maximum 3000 bbls.
	34.1 Gravity
	COMPLETED

Map No. 83 Sec. 26 Twp. 25 R. 14W

Well No. 2 Kipp "E"

Skelly Oil etal Company

Contractor

COMPLETED

SECTION PLAT

C N L SW NW

_____ Ft. from N. Line

993 Ft. from S. Line

_____ Ft. from E. Line

560 Ft. from W. Line

KIP P POOL

6			

Location _____

Rig up _____

Drilling and Remarks:

*Loss 8695
5" @ 3836
7000 rods
Bore + B + 4971
Max 3000
34 1/2*

RECORD

Cased _____ in., _____ ft.

Sand _____

Gas _____

Oil _____

Total Depth 3891

PRODUCTION

1st 24 hrs. Nat. _____

1st 24 hrs. after shot _____

Gas _____ Cu. Ft.

Dry Hole _____

Abandoned _____

Date

JUL 1 1941 19

S. J. LEWIS Scout