

KANSAS

Form 51-5M-7-40-Palace

Stafford

Section 27 Township 25 Range 14-W

Well No. #2 Kipp "A"


Company Skelly Oil

Kipp Pool

NORTH

WEST

EAST

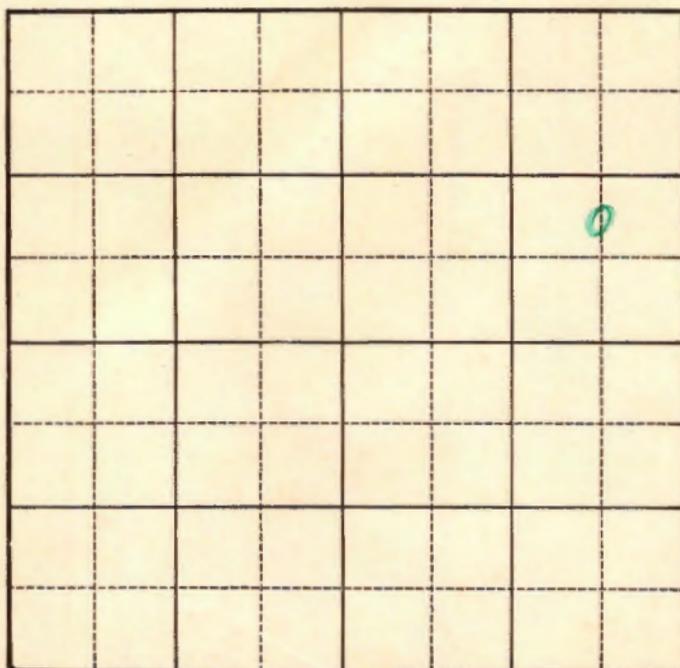

SOUTH

Sec. 27 Twp. 25 R. 14-W

Well No. #2 Kipp "A" Farm _____

Skelly Oil Company _____


(Kipp)

_____ Ft. from N. Line

990 Ft. from S. Line

660 Ft. from E. Line

_____ Ft. from W. Line

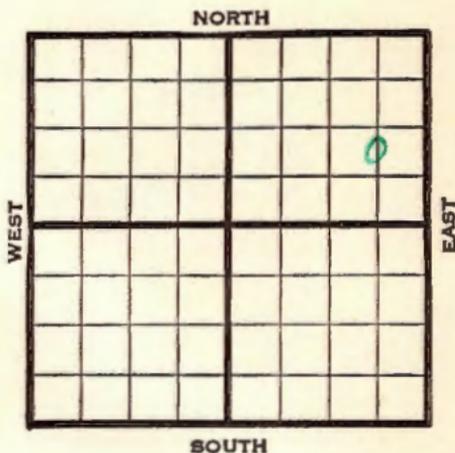

Elev. 1980

1940	REPORT
11/6	Location
11/14	10" - 266' WOC.
11/21	Drlg. 2860'
11/27	Drlg. 3820'
12/5	Drlg. 3859' 1500' oil.
12/12	T.D. 3889' 7000 acid. Flow 75 bbls.
12/19	Flow 109 bbls. 2 hrs, cut 12% BS & W.
12/26	Bomb Potential 768 bbls.
12/30	Lans. 3678' 5" - 3831' T.D. 3889' 7000 acid. Depthograph potential 1587 bbls. MM 34. Gravity
	COMPLETED

Map No. 83 Sec. 27 Twp. 25 R. 14W

Well No. 2 Kipp "A"

Skelly Oil

Company

Contractor

FIRST REPORT

C N L S E N E

 Ft. from N. Line

990 Ft. from S. Line

660 Ft. from E. Line

 Ft. from W. Line

SECTION PLAT

			o

KIPP POOL

Location X

Rig up

Drilling and Remarks:

RECORD

Cased in., ft.

Sand

Gas

Oil

Total Depth

PRODUCTION

1st 24 hrs. Nat.

1st 24 hrs. after shot

Gas Cu. Ft.

Dry Hole

Abandoned

Date

NOV 6 1940

S. J. LEWIS Scout

Map No. 83 Sec. 27 Twp. 25 R. 14W

Well No. 2 Kipp "A"

Skelly Oil Company

Contractor

COMPLETED
C N L S E N E

SECTION PLAT

			o

_____ Ft. from N. Line

990 Ft. from S. Line

660 Ft. from E. Line

_____ Ft. from W. Line

KIPP POOL

Location _____

Rig up _____

Drilling and Remarks:

*Lease 8678.
5" C 3831
7000 acid
Depth. P 81587

34 1/2 G.*

RECORD

Cased _____ in., _____ ft.

Sand _____

Gas _____

Oil _____

Total Depth 3889

PRODUCTION

1st 24 hrs. Nat. _____

1st 24 hrs. after shot _____

Gas _____ Cu. Ft.

Dry Hole _____

Abandoned _____

Date

DEC 30 1940 19

S. J. LEWIS Scout