

KANSAS

Stafford


FORM 51 5M 1-42 PETROL

Section 27 Township 25 Range 14-W

Well No. #4 Kipp "A"

Company Skelly et al

NORTH Kipp Pool

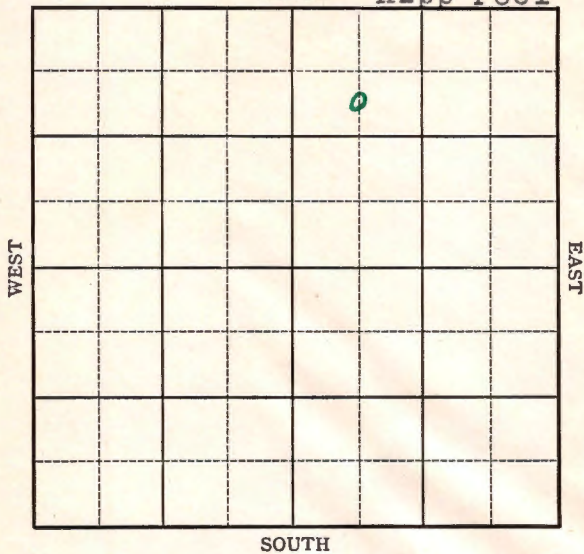

KANSAS

Staff ord

Map No. 83 Sec. 27 Twp. 25 R. 14WWell No. 4 Kipp "A"Skelly et al. Company**FIRST REPORT** Contractor

C SL NW NE

SECTION PLAT

990 Ft. from N. Line Ft. from S. Line Ft. from E. Line660 Ft. from W. Line

		o	

KIPP POOLLocation Rig up

Drilling and Remarks:

Rotary**RECORD**Cased in., ft.Sand Gas Oil Total Depth **PRODUCTION**1st 24 hrs. Nat. 1st 24 hrs. after shot Gas Cu. FDry Hole Abandoned

Date

APR 8 1942 19**S. J. LEWIS**

Stafford

KANSAS

Map No. 83 Sec. 27 Twp. 25 R. 14WWell No. 4 Kipp "A"Skelly et al. Company**COMPLETED** Contractor

C SL NW NE

SECTION PLAT

990 Ft. from N. Line Ft. from S. Line Ft. from E. Line660 Ft. from W. Line

KIPP POOL

Location Rig up

Drilling and Remarks:

Lane 8692
5' @ 3842
5000 acid
Born & Prod. 5257
Max 3000
34' 92

RECORD

Cased in., ft.Sand Gas Oil Total Depth 3892

PRODUCTION

1st 24 hrs. Nat. 1st 24 hrs. after shot Gas Cu. Ft.Dry Hole Abandoned

Date

MAY 13 1942

19

S. J. LEWIS Scout