


Section 27 Township 25 Range 14-W

Well Number #1 H.C. Kipp

Company Skelly et al

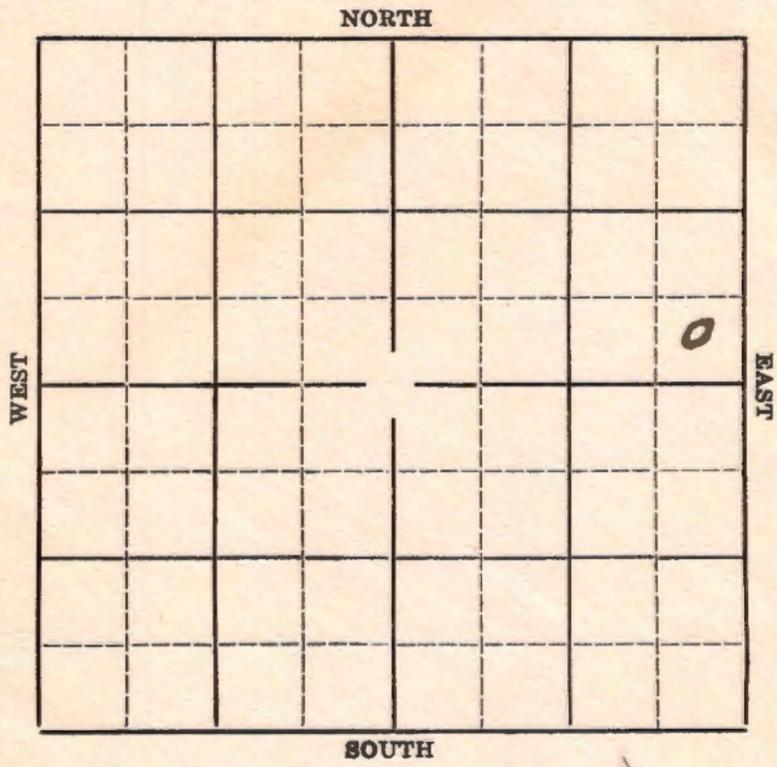

Map No. **KANSAS** Sec. **27** Twp. **25** R. **14W**

Well No. **#1 H.C. Kipp** Farm
Skelly et al Company


_____ Ft. from N. Line

330' Ft. from S. Line

330' Ft. from E. Line

_____ Ft. from W. Line

Elev. 1981

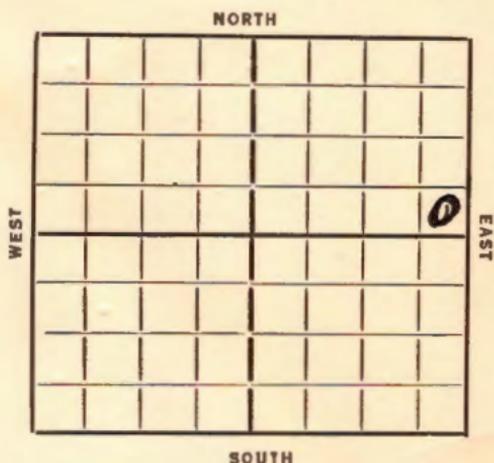

1936

REPORT

- 8/12 Location
- 8/20 Cellar.
- 8/27 Rigging up.
- 9/3 12½" @ 1040'. Drlg.
- 9/10 Drlg. 2493'.
- 9/18 3321' fishing.
- 9/24 **Lansing 3682'**. 8" @ 3691'. RUST.
- 10/1 Bailing mud.
- 10/8 Drlg. 3824'.
- 10/15 -Gas 3895-3900'. TD 3905'. Swabb
158 oil and 85 water in 23 hours.
off bottom.
- 10/22 Drlg. 3970'.
- 10/29 Run pipe 3975'.
- 11/6 7" @ 3978 3996 Fishing
- 11/12 Drlg. 4032
- 11/19 Drlg. 4075'.
- 11/27 6" @ 4083'. **Viola 4092'**.
T. D. 4097'.

OVER

1936

12/3 Viola 4107' Corrected. S.L.M.
Drlg. 4157'.

12/10 Simpson 4205'. Sil. 4240'.
T. D. 4250'. 3000' water.
Cement back to 4118'.

12/17 Shut down.

12/24 P.B. 3914'. 7" @ 3825'. WOC.

12/29-----

1937

1/7 Shot 40 qts. 3817-27' No test.

1/14 Ripping pipe @ 3450'.

1/21 " " " "

1/28 2000 acid @ 3017'. 3000 acid @
3846'. Tubing set 3846'.
Testing.

2/3 Kansas City lime 3847'.

T. D. 4250'.

P.B. 3906'.

2000 acid.

3000 acid.

Flow 1266 oil cut 2% B.S.

COMPLETED

COMPLETED

KANSAS

Map No. 83 Sec. 27 Twp. 25 R. 14W

Well No. 1 N. C. Kipp

Shelby & Co Company

Contractor

SECTION PLAT

			0

_____ Ft. from N. Line

330 Ft. from S. Line

330 Ft. from E. Line

_____ Ft. from W. Line

FIRST REPORT

Location ✓

Rig up _____

Drilling and Remarks:

RECORD

Cased _____ in., _____ ft.

Sand _____

Gas _____

Oil _____

Total Depth _____

PRODUCTION

1st 24 hrs. Nat. _____

1st 24 hrs. after shot _____

Gas _____ Cu. Ft.

Dry Hole _____

Abandoned _____

Date

AUG 12 1936

19

S. J. LEWIS

Scout

Map No. 83 Sec. 27 Twp. 25 R. 14W

Well No. 1 H.C. Kijer

Skelly Oil Company

Contractor

SECTION PLAT

_____ Ft. from N. Line

830 Ft. from S. Line

230 Ft. from E. Line

_____ Ft. from W. Line

			0

COMPLETED

Location _____

Rig up _____

Drilling and Remarks:

*Kansas City line
2847*

PB3906

2000 acid

3000 acid

Flow 1266 oil

cut 2% B.S.

RECORD

Cased _____ in., _____ ft.

Sand _____

Gas _____

Oil _____

Total Depth 4250

PRODUCTION

1st 24 hrs. Nat. _____

1st 24 hrs. after shot _____

Gas _____ Cu. Ft.

Dry Hole _____

Abandoned _____

Date

FEB 3 1937 19

S. J. LEWIS

Scout