

KANSAS


Stafford

FORM 51 5M 10-41 PETROL

Section 27 Township 25 Range 14-W ✓

Well No. #1 T. A. Toland

Company Skelly

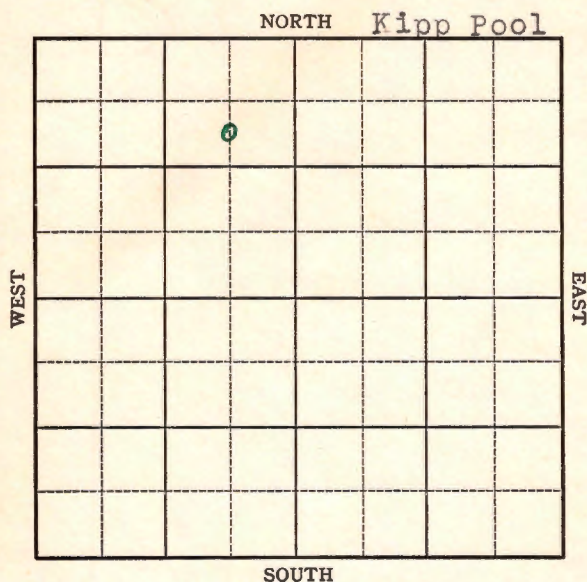

Sec. 27 Twp. 25 R. 14-W

Well No. #1 T. A. Toland Farm

Skelly Company

(Kipp)


990 Ft. from N. Line

Ft. from S. Line

660 Ft. from E. Line

Ft. from W. Line

Elev. 1981

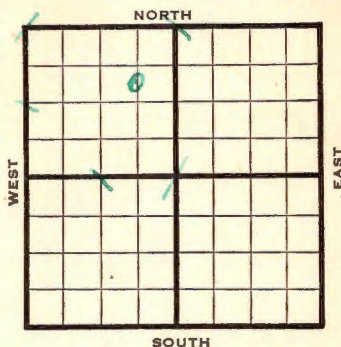

1942

REPORT

7/1	Rotary.	
7/8	8" - 426'	Drlg. 1860'
7/15	Fsg. 2277'	
7/22	" "	
7/29	Drlg. 3685'	
8/5	Lans. 3712	5" - 3758 $\frac{1}{2}$
	T.D. 3760	RUST
8/12	TD 3906 Water	PB
8/19	PB 3785'	
8/27	PB 3752	
9/2	PB 3743	
	45 shots 3712-21 no shows	1000 acid
9/9	Lans. 3712	5" - 3758 $\frac{1}{2}$
	Water	T.D. 3906

ABANDONED

Stafford KANSAS

Map No. 23 Sec. 27 Twp. 25 R. 14WWell No. 1 T. A. Toland

Skelly

Company


FIRST REPORT

Contractor

SECTION PLAT

C S $\frac{1}{2}$ NE NW990 Ft. from N. Line Ft. from S. Line660 Ft. from E. Line Ft. from W. Line

Kipp Pool

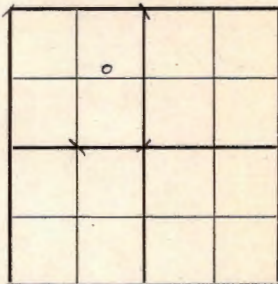Location Rig up

Drilling and Remarks:

Rotary

RECORD

Cased in., ft.Sand Gas Oil Total Depth

PRODUCTION

1st 24 hrs. Nat. 1st 24 hrs. after shot Gas Cu. Ft.Dry Hole Abandoned

Date

JUL 1 1942 19S. J. LEWIS

Scout

KANSAS

Stafford

Map No. 83 Sec. 27 Twp. 25 R. 14WWell No. 1 T. A. Toland

Skelly

Company

ABANDONED

Contractor

C S $\frac{1}{2}$ NE NW990 Ft. from N. Line

Ft. from S. Line

660 Ft. from E. Line

Ft. from W. Line

SECTION PLAT

	o		

KIPP POOL

Location

Rig up

Drilling and Remarks:

*Loss 37 1/2.**5" @ 3758 1/2.**Water.*

RECORD

Cased _____ in., _____ ft.

Sand _____

Gas _____

Oil _____

Total Depth 3906

PRODUCTION

1st 24 hrs. Nat. _____

1st 24 hrs. after shot _____

Gas _____ Cu. Ft.

Dry Hole _____

Abandoned _____

Date

SEP 9 1942 19

S. J. LEWIS Scout