

Stafford

KANSAS

Section 32 Township 25 Range 1WWell No. 1 BoylonCompany Helmerich & Payne

NORTH

							0

WEST

EAST

SOUTH

Stafford

KANSAS ✓

Sec. 32 Twp. 25 R. 14W

Well No. #1 Boylon Farm

Helmerich & Payne Company

Hilton Drlg. Contractor
Wildcat


Ft. from N. Line

330 Ft. from S. Line

330 Ft. from E. Line

Ft. from W. Line

SE SE SE
Carter Acreage &
supp.

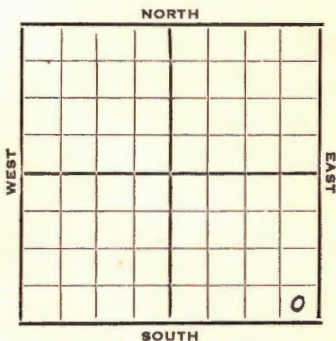

1952 ELEV. 2006' REPORT

12/10 Location

12/11 Location

12/18 10" @ 242 Anhy 915 Ø2450

12/25 " " "

1953

1/7 Spud 12-11-52

D&A

TD 4534'

10" @ 342

Anhy 915, Heeb. 3619, Br lime

3774, B KC 4097, Cong. 4211, Miss

4234, Viola 4354, Simp 4435, Arb.

4493

TD 4534

D&A

ABANDONED

County **Stafford** State **Kansas**
 Sec. **32** (Blk. Twp.) **25** (Sur. Rge.) **14W** Map No.
 Operator **Helmerich & Payne**
 Well No. **1** Farm **Boylon**
 Elev. Location **SE SE SE**

FIRST REPORT

330 Ft. From **S** Line **SE**

330 Ft. From **E** Line Quarter

1st. Report **DEC 10 1952**

Completion

Remarks **Carter Acreage & supp**

Hilton Drlg. - Contr.

Spudding Date

Drig. Data

Wildcat

Location

J. G. McGEHEE

County Stafford State Kansas
 Sec. 32 (Blk.) 25 (Sur.) 14W Map No.
 Operator Helmerich & Payne
 Well No. 1 Farm Boylon
 Elev. 2006 Location SE SE SE



330 Ft. From S Line SE
330 Ft. From E Line Quarter
 Ist. Report
 Completion JAN 7 1953
 Remarks Wildcat
Hilton Drlg. - Contr.
 Spudding Date 12-11-52

Drlg. Data D & A TD 4534
10" @ 342 Anhy 915 Heeb. 3619
Br. lime 3774 B KC 4097 Cong. 4211
Miss. 4234 Viola 4354 Simp. 4435
Arb. 4493 TD 4534

D & A

J. G. McGEHEE