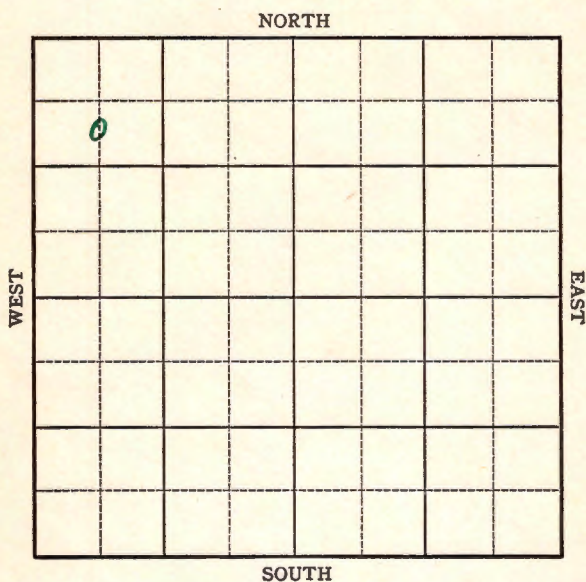


Stafford

KANSAS

Section 26 Township 25 Range 14-WWell No. #3 Kipp "E"Company Skelly et al.

KANSAS

Stafford

Sec. 26 Twp. 25 R. 14-W

Well No. #3 Kipp "D" Farm

Skelly et al Company


(Kipp)

990 Ft. from N. Line

Ft. from S. Line

Ft. from E. Line

660 Ft. from W. Line

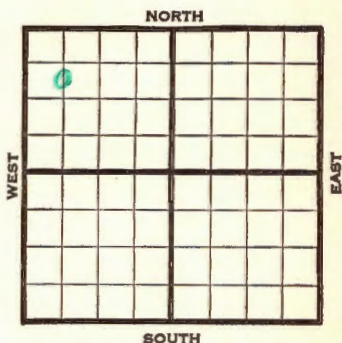

Elev. 1977

1941	REPORT
11/25	Location
12/4	8" - 396' WOC.
12/11	Drlg. 2590
12/18	Lans. 3705
	TD 3847 Run csg. SO
12/24	5" - 3825' Drlg. 3885'
	Gas.
12/30	Lans. 3705
	5" @ 3825
	TD 3900
	7000 acid
	Pump & Flow 2051 Potential
	34.1 Grav.
	COMPLETED

Map No. K-83 Sec. 26 Twp. 25 R. 14WWell No. 3 Kipp "E"Skelly et al. CompanyFIRST REPORT Contractor

C SL NW NW

990 Ft. from N. Line Ft. from S. Line Ft. from E. Line660 Ft. from W. Line

SECTION PLAT

o			

KIPP POOL

Location XXRig up

Drilling and Remarks:

RECORD

Cased in., ft.Sand Gas Oil Total Depth

PRODUCTION

1st 24 hrs. Nat. 1st 24 hrs. after shot Gas Cu. Ft.Dry Hole Abandoned

Date

NOV 25 1941 19

S. J. LEWIS

Scout

Stafford

KANSAS

Map No. 83 Sec. 26 Twp. 25 R. 14WWell No. 3 Kipp "E"Skelly et al.

Company

COMPLETED

Contractor

C SL NW NW

990 Ft. from N. Line

Ft. from S. Line

Ft. from E. Line

660 Ft. from W. Line

SECTION PLAT

o			

KIPP POOL

Location

Rig up

Drilling and Remarks:

Home 3705-5" @ 3825.7000 acidPump & Flow. 205134 1/2

RECORD

Cased _____ in., _____ ft.

Sand _____

Gas _____

Oil _____

Total Depth 3700

PRODUCTION

1st 24 hrs. Nat. _____

1st 24 hrs. after shot _____

Gas _____ Cu. Ft.

Dry Hole _____

Abandoned _____

Date

DEC 30 1941

19

S. J. LEWIS Scout